


Resurvey

Township 1st 20th N. Range 1st 5th W. Mex. Mich.

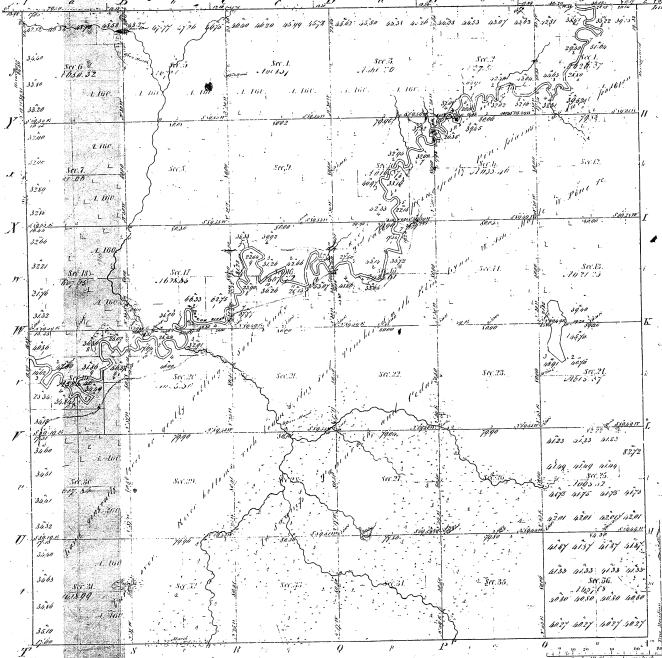

Measurements of
 1841
 1842
 1843
12-44

18-4

Standard 1/2 mile 1/2 barometer 10.144

See also standard paper and plan to the survey

Total number of Acres 32206.32

Harvest	When Harvested	Date of Census	Amount of Harvest	When Harvested	Amount of Harvest
Wheat	1850	July 21 1851	21 1/2	1851	1 1/2
Indian Corn	1850	May 20 1851	27 08 08	1851	15 1/2
Indian Corn	1850	May 20 1851	27 08 08	1851	15 1/2

The above copy of Township 1st 20th North of Range 1st 5th West of the Principal Meridian of Michigan is hereby confirmed to the following persons named in the margin, which have been examined and approved by the surveyor thereof for the same purpose, which have been examined and approved by the surveyor thereof for the same purpose, which have been examined and approved by the surveyor thereof for the same purpose.

Wm. B. Garrison
 J. B. Garrison
 J. B. Garrison