


Township N. VII North, Range N. III West, Mer. (McC. Ter.)

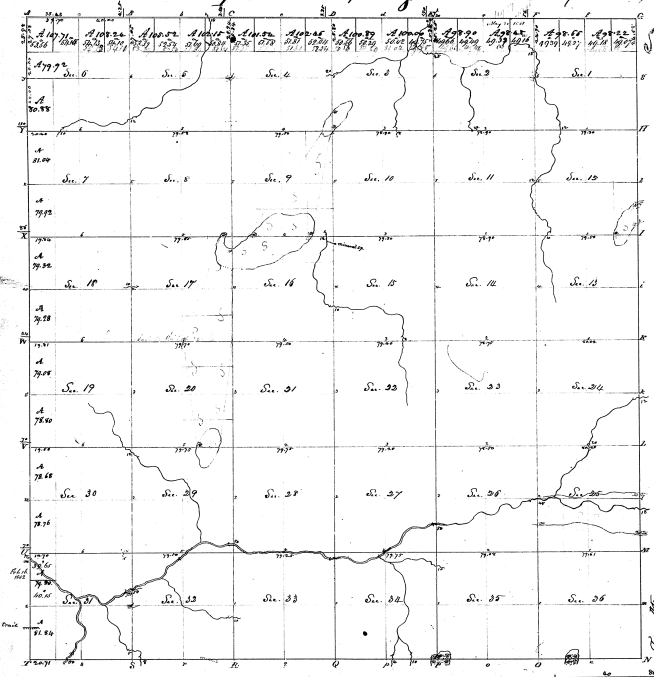

Surveyed in April 1831 - by Jas. Wright, C.S.

The above map of Township N. VII North, Range N. III West, Mer. (McC. Ter.) is divided conformable with field notes of the Survey thereof on file in this office which have been examined & approved by the Surveyor General's Office & M. T. Williams Surveyor General, Dec. 8. 1831

Contents			
Sections	Acres	Sec. Conts.	Acres
1	36	60	2160
2	36	60	2160
Total			77760

32  
5-15