


Rd Survey

Township N^o 26 N. Range N^o 4 W

Mer. Michigan

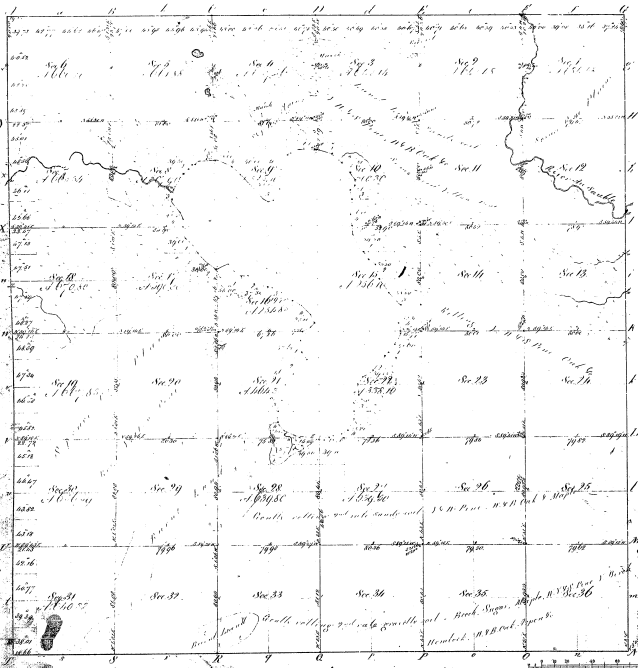

Section	Area	Owner
1		
2		
14-17

Total number of Acres 71 3/4 68

Name	By whom Surveyed	Date of Survey	Amount of Survey M. 33'	When Surveyed	When Checked by the Surveyor's Office
McKenzie	John McMillan	Feb. 21 1859	11 7 1/2	1859	1859
McNeil	William P. Brown	April 22 1859	18 25 1/2	1859	1859

The above Report of Township N^o 26 North of Range 4th West of the Principal Meridian Michigan, is hereby recommended to the full and final survey thereof by the office of the Surveyor General and approved
Surveyor General Office
Detroit, March 1859
Charles Little, Sur. Genl