



Township N^o 39 N. Range N^o 22 W.

Mer. Mich.

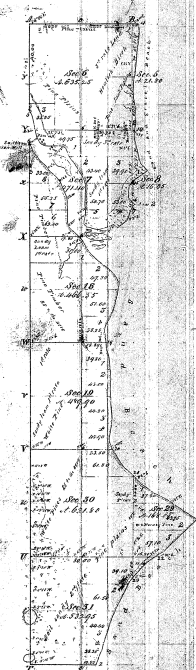

Little Bay De-Noc.

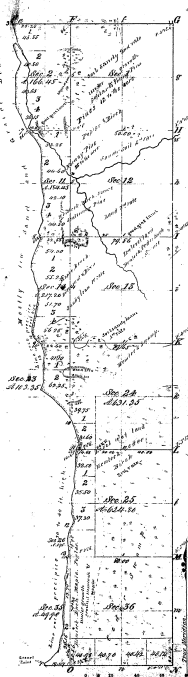

Merritt's					
Page	Course	ALIAS	Page	Course	ALIAS
46			20		

Error - See Attachment & page 27, making total amount \$1,276.36

Total number of Acres 2074.10

Survey Required	Survey	Date of Survey	Amount of Survey	Plan Deposition	When Charged in the field book
Survey			\$37.12		
Subdivision			\$2,736.98		

The above Map of Township N 39 N, Range N 22 W, Mer. Mich.
 and also the survey on file in the Office of the Register of the
 Michigan General Land Office, in the Office of the Register of the
 Michigan General Land Office, is hereby approved and affirmed.
 (Signature) _____

46-23