


Township N^o 40 N. Range N^o 18 W. Mer. Mich.

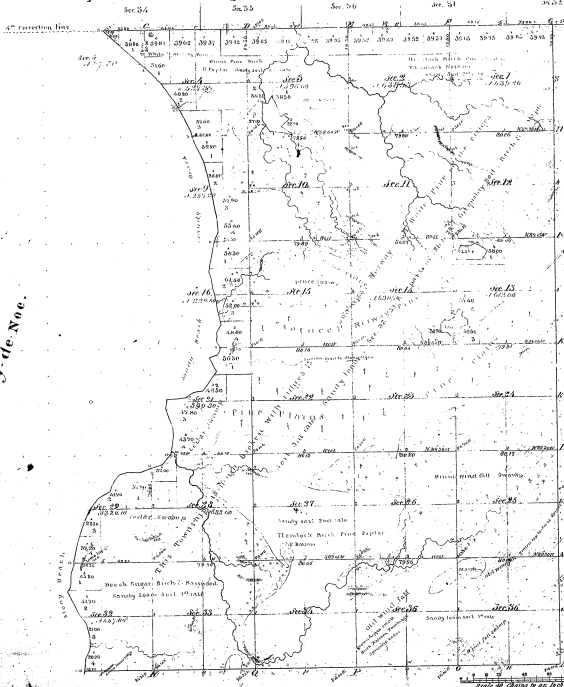

Big Bay de Noc.

Schedule of		Census (1850)	Census (1860)	Census (1870)	Census (1880)
Page	Page				
1	1				
2	2				
3	3				
36	36				

46-14

Total number of Acres 1621.00

Survey	By whom Surveyed	Date of Conced.	Amount of Survey	Area Surveyed	Area charged to the Surveyor
Original	John Wood	1836	1621.00	1621.00	1621.00
Amended	A. M. Wood	1840	1621.00	1621.00	1621.00

The above Map of Township N^o 40 North of Range N^o 18 West of the Principal Meridian Michigan is a copy of the original map of the same, which has been examined and approved by the Surveyor General Office.
 Surveyor General Office
 Lansing, Michigan