


Township N° 40 N. Range N° 20 W.

Mer. Mich.

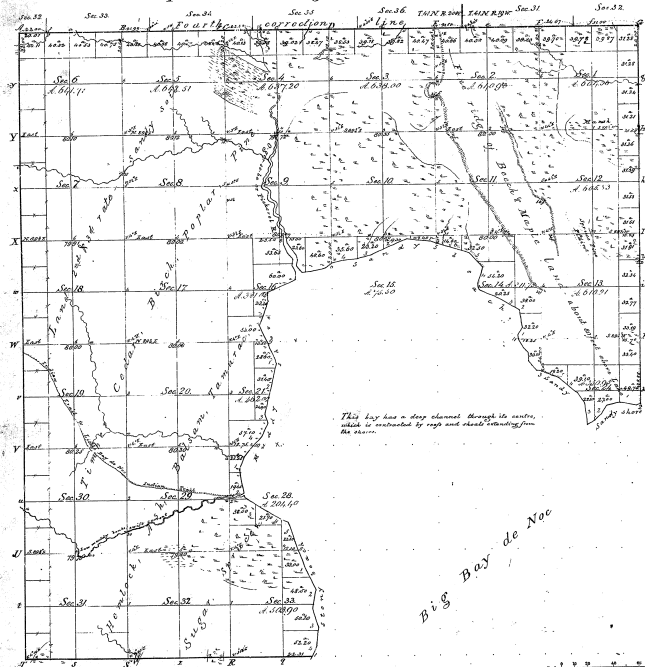

This map has a deep channel through its center, which is indicated by eggs and short branching from the center.

Big Bay de Noc

Acres of		of		of	
Paul	Conroy	Paul	Conroy	Paul	Conroy
46	17				
Total Non-land 355.66					

46-12

Total number of Acres 33,460.60

Source Designated	By Whom Surveyed	Date of Contract	Survey of Survey	When Surveyed	When Contracted
Township lines	John Bond	February 18th	6. 11. 19	23. 9. 18	1850
Subdivisions, Meanderers	J. Maryweather	February 21. 1852	29. 7. 22	2. 4. 23	1852

The above map of Township N° 40 North of Range N° 20 West of the Principal Meridian, Michigan, is hereby approved as the field notes of the survey shown on it in this office, and has been examined and approved.

Surveyor General's Office,
Detroit, Mich. 1852

Lucius Dwyer, Secy. Genl.

Handwritten notes and signatures.