


Township N^o 41 N. Range N^o 18 W. Mer. Mich.

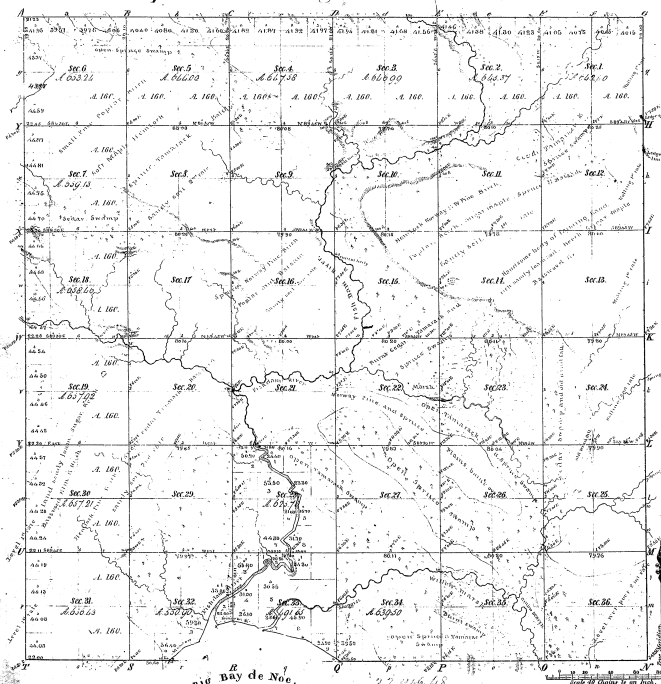

Boundaries of		Provl. Course		VCLL-Provl. Course		VCLL	
Provl. Course	VCLL	Provl. Course	VCLL	Provl. Course	VCLL	Provl. Course	VCLL
31-34							
Total of Original							
3, 28, 22							

37-31

Big Bay de Noe.

22, 21, 26, 48

Total number of Acres 22, 216, 48

Survey designated	By Whom Surveyed	Date of Contract	Amount of Surveyed	When Surveyed	When Surveyed
Township Range	John Ross	1847-11-10	22, 216, 48	1847	1848
Subdivisions	A. Macgregor	22, 1100	22, 216, 48	1847-11-10	1848

The above Map of Township N^o 41 North of Range N^o 18 W of the 1st Principal Meridian Michigan is hereby registered in the field notes of the survey being on file in this office which have been examined and approved.

Surveyor General's Office
Detroit April 19, 1852
L. Cassin, Deputy Surveyor General