


Township N<sup>o</sup> 41 N. Range N<sup>o</sup> 23 W. Mer. Mich

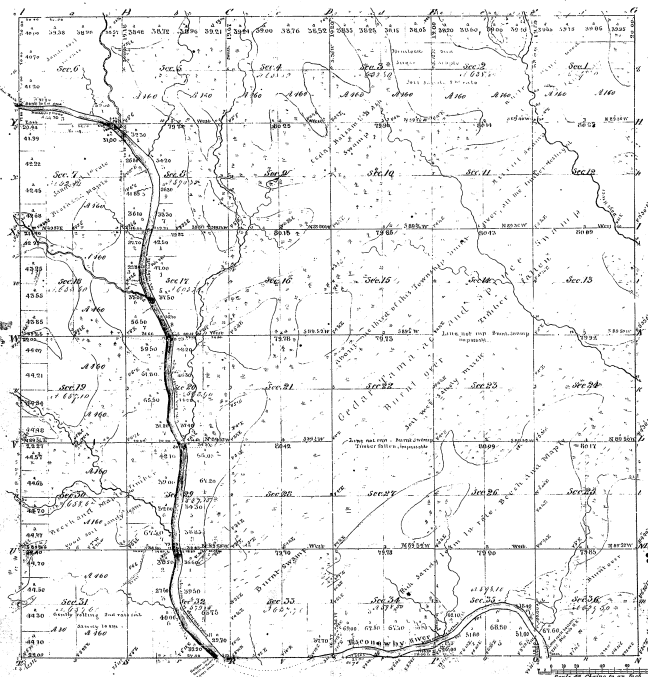

Section No.	Acres	Value	Owner	Value	Owner	Value	Owner	Value
38	36							

38-36

Total number of Acres 33,116. 05.

Survey completed	By Whom Surveyed	Date of Conduct	Amount of District	Who Surveyed	When Charged to the District?
Township Survey	John Peck	Feb 26 <sup>th</sup> 1855	20 20 00	Geo. Peck	
Subdivisions	A. Metzger	July 18 <sup>th</sup> 1856	74 27 34	Geo. Peck	

Wherefore Map of Township N<sup>o</sup> 41 North of Range O<sup>o</sup> 23 West of the Principal Meridian, Michigan is hereby confirmed to the full area of the survey thereon on file in this Office, which have been examined and approved.

Township Survey Office  
March 30 1857

Lucus Lyon, Secy Genl