


Township N<sup>o</sup> 43 N. Range N<sup>o</sup> 19 W. Mer. Mich.

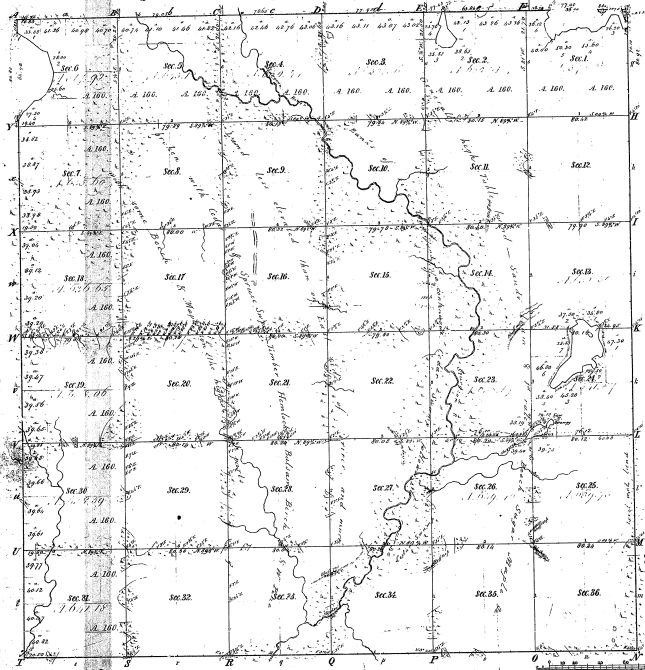

Members of  
 First Course 1851  
 First Course 1852  
 First Course 1853

37-26

37-26

Total number of Acres 29,740.36

Survey designated	By whom surveyed	Date of Contract	Amount of Survey	When Surveyed	From what Sec. or Cont.
Township 43 N.	J. B. Cook	April 7, 1851	16 Sec. 24	2 <sup>d</sup> June 1851	1 <sup>st</sup> Cont. 1851
Subdivisions	M. J. Spooner	June 8, 1859	62. 21. 36	1 <sup>st</sup> June 1859	

The above Map of Township 43 North of Range 19 West of the Principal Meridian was prepared by the said members of the survey being for the use of the Office, which have been examined and approved.  
 Surveyor General's Office  
 Detroit, Feb. 21, 1862  
 Geo. W. Allen  
 Sur. Genl.