


Township N.º 48 N. Range N.º 47 W. Mer. Mich.

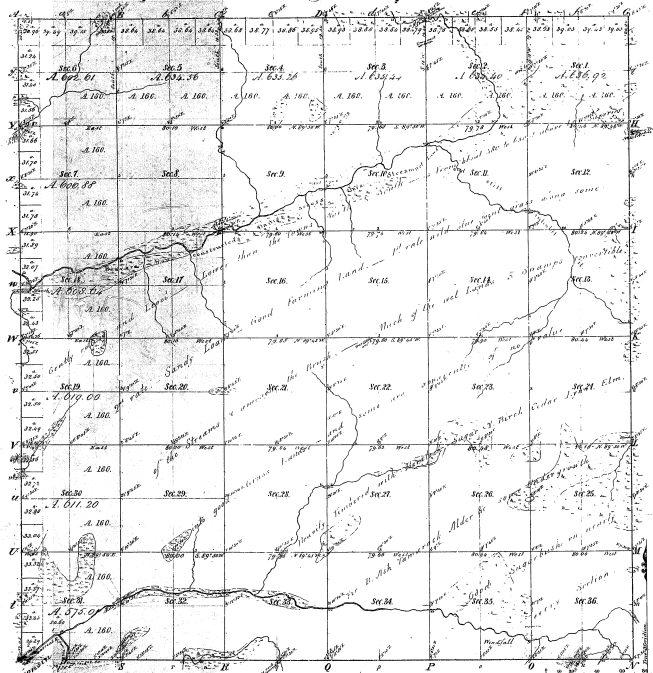

Number of
 (1) (2) (3) (4) (5) (6) (7) (8) (9) (10) (11) (12) (13) (14) (15) (16) (17) (18) (19) (20) (21) (22) (23) (24) (25) (26) (27) (28) (29) (30) (31) (32) (33) (34) (35) (36)

42 7

42-17

Total number of Acres 27740.92

Surveys designated	By whom surveyed	Date of Contract	Amount of Survey	When Surveyed	Acres
Township, Range	A. P. Rice	April 27, 1847	71	1847	1847
Subdivisions	P. H. Rice	1847	16	1847	1847

The above Map of Township N.º 48 N., Range N.º 47 W., Mer. Mich. is a true and correct copy of the original survey map on file in the Office, which has been examined and approved.

Surveyor General's Office
 Detroit, Jan 11 1847
 Lewis G. Spier, Sur. Genl.

Survey of 1847