


42-13

LAKE SUPERIOR.

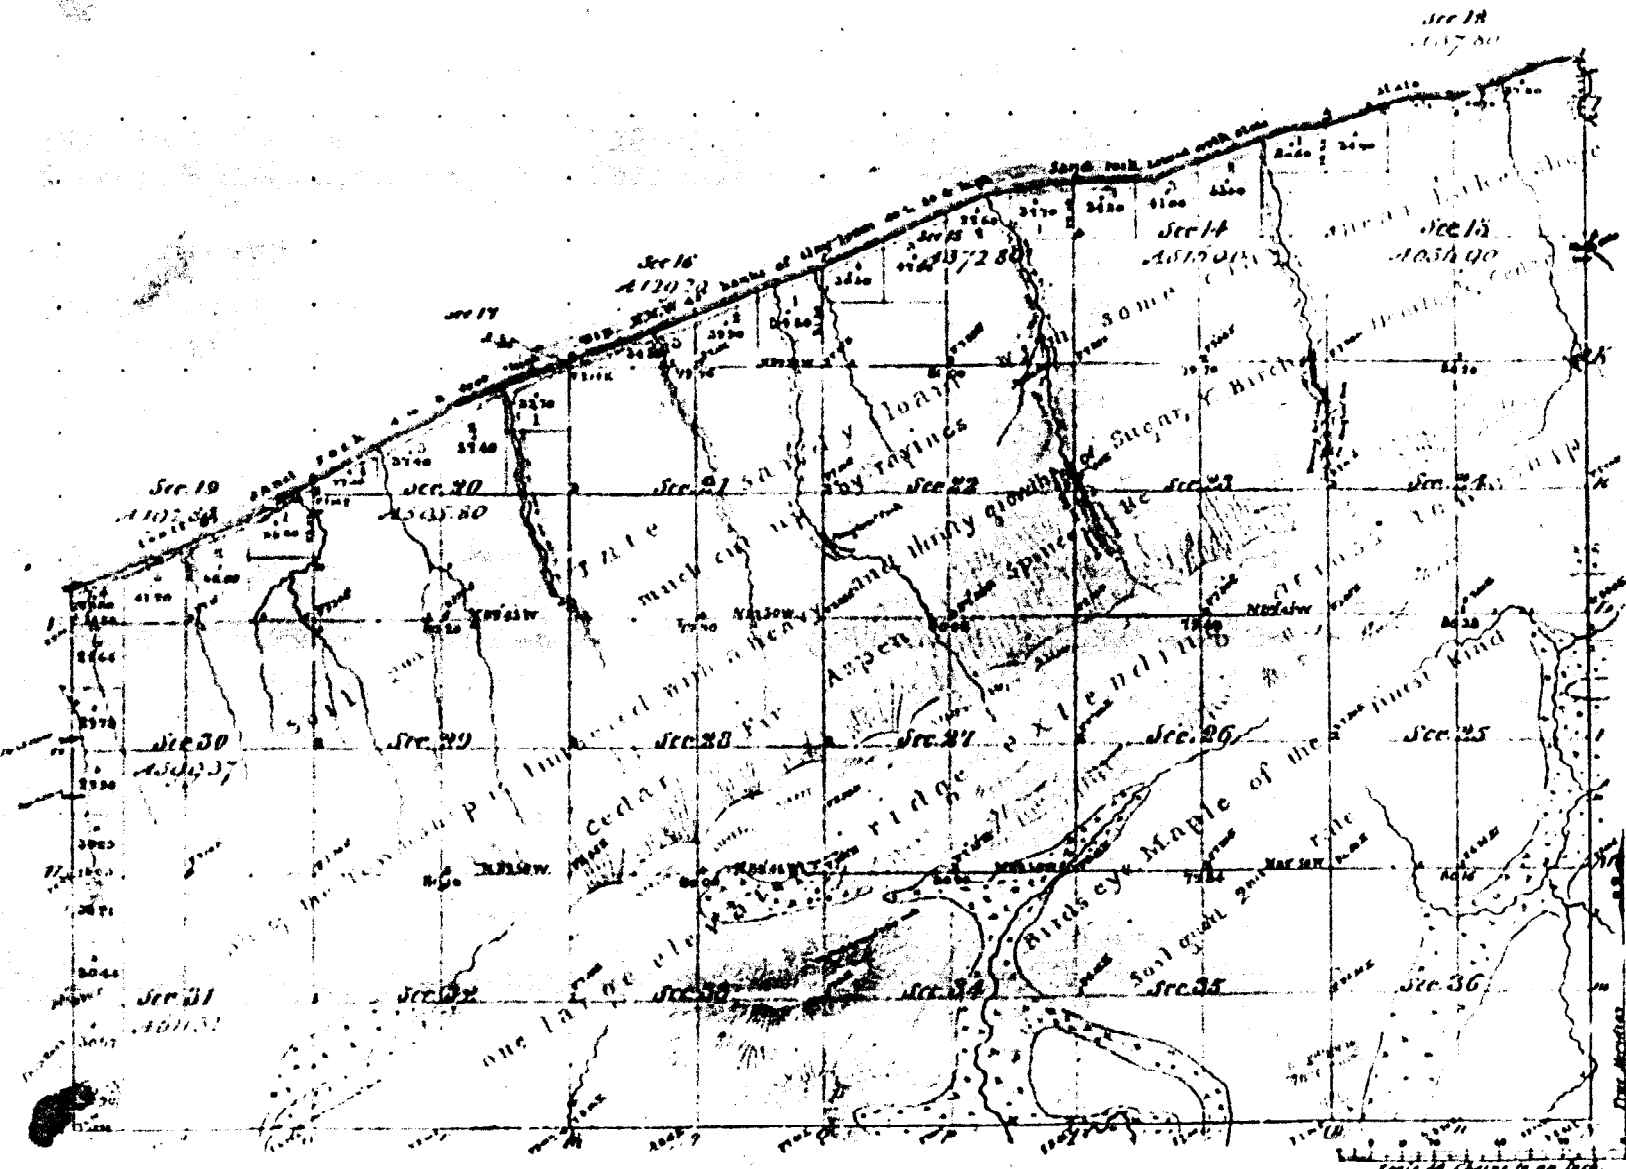

Total manders of

Total number of Acres 12,560.05

Survey Designated	By Whom Surveyed	Date of Contract	Amount of Survey M. Co. Lot	When Surveyed	When Closed in the State's Office
Township line	John G. Bond	July 1847	10. 07. 66	July 1847	
Subdivisions	William Bond	Dec. 1849	55. 45. 63	Jan 1848	

The above Map of Township N. 49. N. Range N. 47 W. Mer. Mich. is a study conformable to the files of the survey thereof on file in this Office, which have been examined and approved by the Surveyor General's Office.
 Detroit, January 3, 1849.
 Lucius Lyon, Surveyor General