


Township *N.V. south*, Range *N.W. west* (Mild. Sec.)

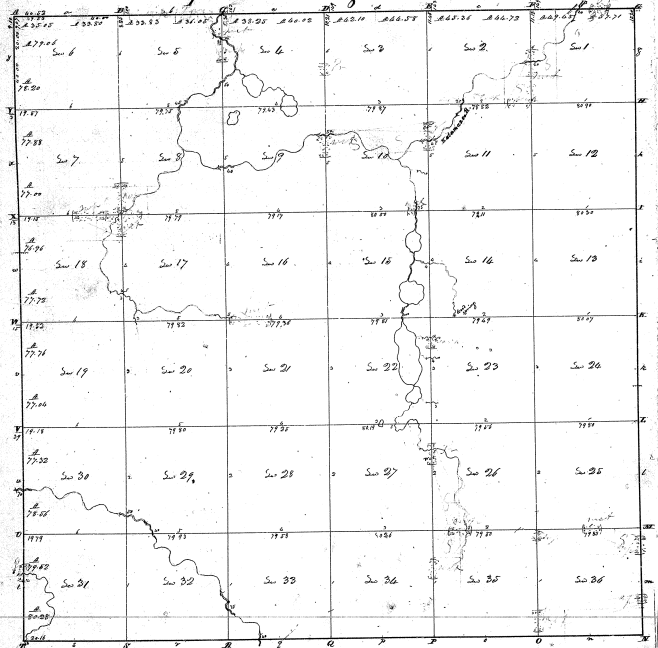

4-7

4-7

Surveyed in March 1825 by Robert Clark jr.