


Township N 7 south, Range N 1 west (M.D. 1855)

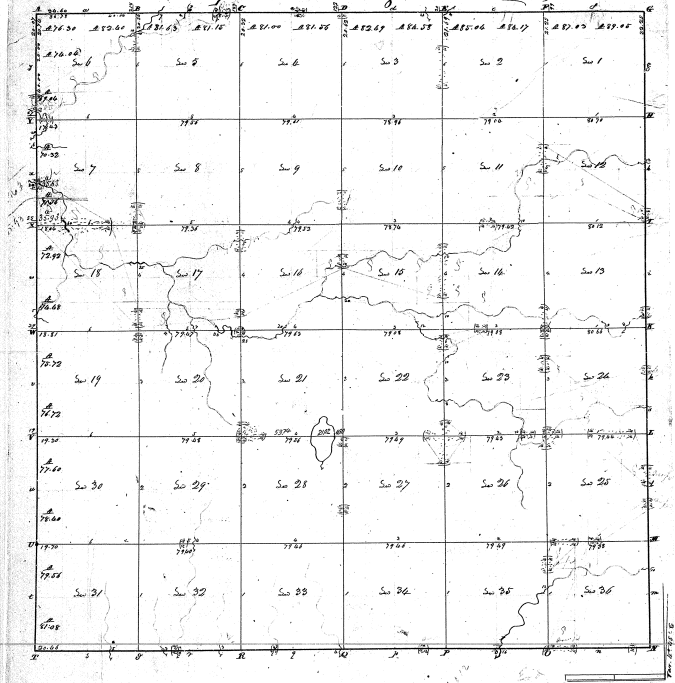

4-11

4-11

Surveyed for Jan. 1855
by Robert Clark jr.