


Township N. VIII south, Range N. III west Mer. (M. 76.)

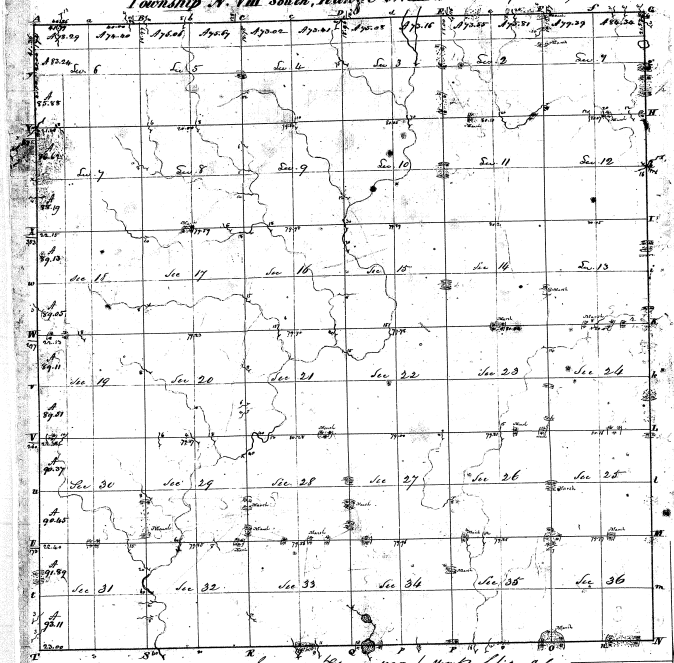

Changed in February 1925 by Mr. Bondville et al.

H-31

H-30