


Township N. V. north, Range N. VIII west Mer. (Mts. Ter.)

24

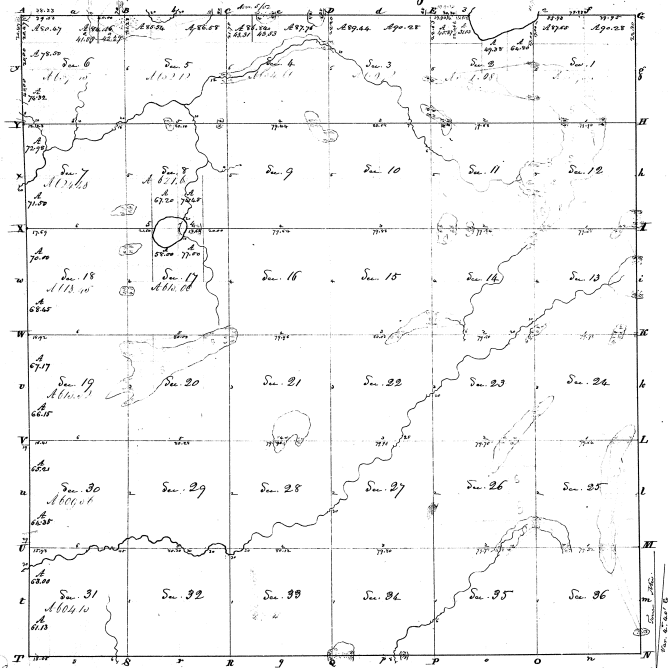

Comp.

Surveyed in October & November, 1930, by John Mullett & S.

Scale as shown on map

Cont'd

Section	Acres	Acres	Section	Acres	Acres
Sec 17 1	30.00		Sec 19	32.00	
Sec 2	30.00		Sec 20	30.00	
Sec 3	30.15		Sec 21	30.00	17
Sec 4	30.00		Sec 22	30.00	
Sec 5	32.00		Sec 23	30.00	66.18
Sec 6	32.00		Sec 24	30.00	
Sec 7	32.00		Sec 25	30.00	
Sec 8	32.00		Sec 26	30.00	
Sec 9	32.00		Sec 27	30.00	
Sec 10	32.00		Sec 28	30.00	
Sec 11	32.00		Sec 29	30.00	
Sec 12	32.00		Sec 30	30.00	
Sec 13	32.00		Sec 31	30.00	
Sec 14	32.00		Sec 32	30.00	
Sec 15	32.00		Sec 33	30.00	
Sec 16	32.00		Sec 34	30.00	
Sec 17	32.00		Sec 35	30.00	
Sec 18	32.00		Sec 36	30.00	
Sec 19	32.00				
Sec 20	32.00				
Sec 21	32.00				
Sec 22	32.00				
Sec 23	32.00				
Sec 24	32.00				
Sec 25	32.00				
Sec 26	32.00				
Sec 27	32.00				
Sec 28	32.00				
Sec 29	32.00				
Sec 30	32.00				
Sec 31	32.00				
Sec 32	32.00				
Sec 33	32.00				
Sec 34	32.00				
Sec 35	32.00				
Sec 36	32.00				

Page 9