


Township N. VIII North, Range N. VI west Mer. (Min. Ter.)

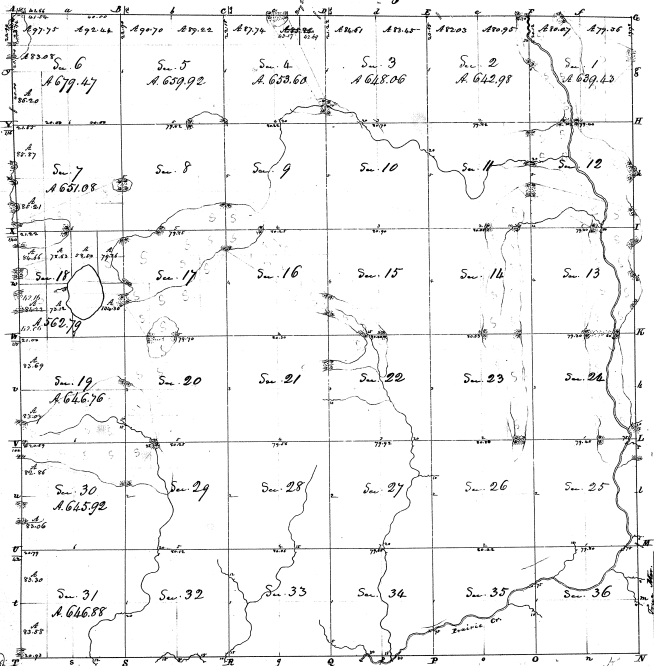

Total Acres 2307.84

Original designator	As shown changed	Date of change	Act. of change	Max. change	Min. change
Original designator	R. Colwell	17. Nov. 1870		197.151	197.151
As shown changed	G. Robinson	18. "		61.23.29	197.151

The above Map of Township N. VIII North, Range N. VI west Mer. of the Principal Meridian, Michigan Territory, is hereby confirmed to the field notes of the Survey thereof on file in the office, which have been examined and approved.

Surveyor General's Office E. M. Pillsbury
 Cincinnati, March 28th 1852

Mileage of small lakes in Sec. 18	
Square Feet	
1235 5/16	to Lake Thomas
5 86 8	to do
5 428 1/2	to do
4 10 6	to do
4 3 1/2	to do
4 22 1/2	to do
5 27 1/2	to do
5 25 1/2	to do
5 24 1/2	to do
5 23 1/2	to do
5 22 1/2	to do
5 21 1/2	to do
5 20 1/2	to do
5 19 1/2	to do
5 18 1/2	to do
5 17 1/2	to do
5 16 1/2	to do
5 15 1/2	to do
5 14 1/2	to do
5 13 1/2	to do
5 12 1/2	to do
5 11 1/2	to do
5 10 1/2	to do
5 9 1/2	to do
5 8 1/2	to do
5 7 1/2	to do
5 6 1/2	to do
5 5 1/2	to do
5 4 1/2	to do
5 3 1/2	to do
5 2 1/2	to do
5 1 1/2	to do

6-11