


Township A<sup>o</sup> 45 N. Range N<sup>o</sup> 31 W. Mer. Mich.

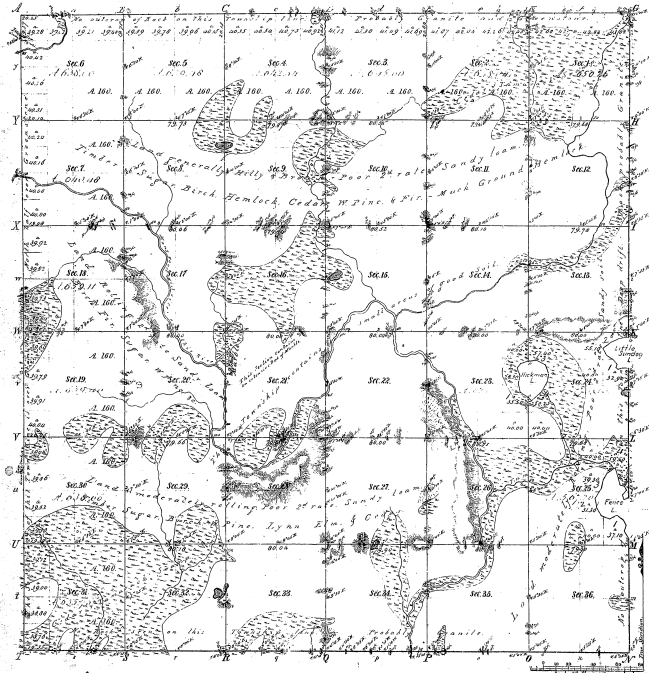

45-24

Section	Owner	Acres	Remarks
1			
2			
Total number of Acres 22,004.76

Survey Designated	By Whom Surveyed	Date of Contract	Amount of Survey	Plan Surveyed	Plan of Map and all in "See Remarks"
Township Acres	W.D. Swindell & Co.	April 7, 1864	22,004.76	5 <sup>th</sup> on 1864	
Subdivisions					

This new Map of Township A 45 N. R. 31 W. Mer. Mich. is a true and correct copy of the original survey made by W.D. Swindell & Co. in 1864 and is hereby confirmed to the full area of the survey thereon by me in the office and has been examined and approved.

Surveyor General's Office  
 District of Michigan  
 Charles F. Allen  
 Sur. Genl.