


Resurvey
Township N^o 16. N. Range N^o 6. W. Mer. Mich.

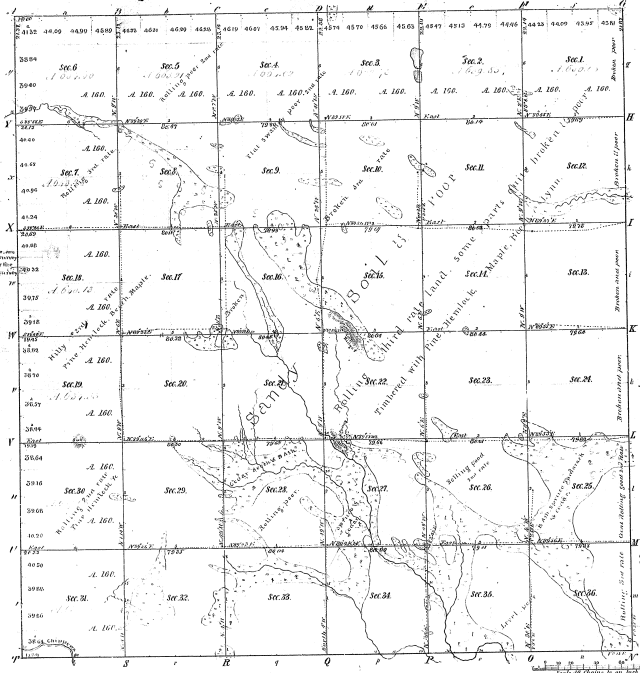

Note

This section does not show any
on the lines of the township
and is not to be taken by
disregarding the section

Number of	Course	Acres	Course	Acres	Course	Acres
12		9				

Total number of Acres

Survey Designated	By Whom Surveyed	Date of Contract	Amount of Survey	When Surveyed	How Surveyed	How Surveyed
Township lines	Wm. H. Allen	Jan 17 1857	36 00 00	3 0 1857	By G. M. Allen	By G. M. Allen
Subdivisions	Wm. H. Allen	April 12 1857	60 00 00	3 0 1857	By G. M. Allen	By G. M. Allen
		April 14 1857	57 4 58	1 0 1857	By G. M. Allen	By G. M. Allen

The above copy of Township N. 16 North of Range N. 6 West of the
Principal Meridian of Michigan
is hereby confirmed to the field notes
of the survey thereof on file in this office, which have been examined and approved.
Surveyor General of Mich.
Robert C. McMillan

Dec 15 1857

12-19