


Township N^o 56 N Range N^o 51 W

Mer. Mich.

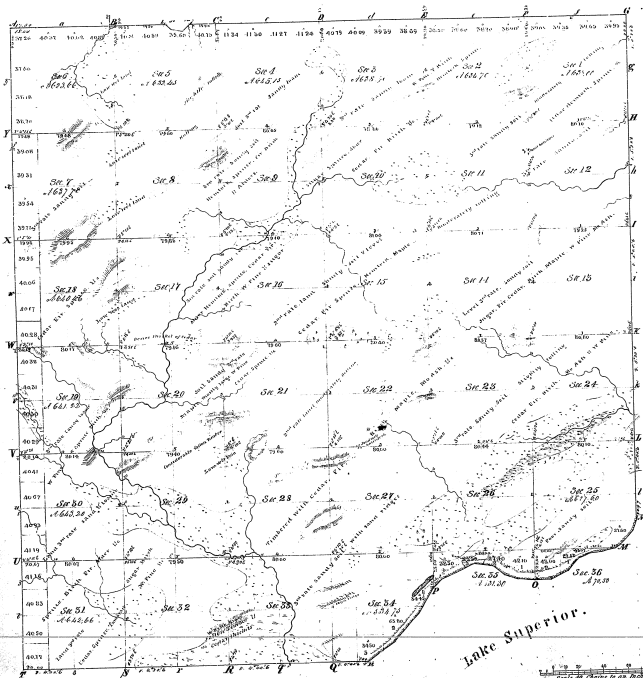

Boundaries of
Township N^o 56 N Range N^o 51 W Mer. Mich.

40-10

40-40

Total number of acres 214,98 2/3

Original Subdivided	By What Surveyed	Date of Original	Amount of Survey	Area Surveyed	Area Claimed on the said lands, etc.
	W. H. H. H.	1856	61,643 2/3	2	111
	W. H. H. H.				
	W. H. H. H.				

All above Map of Township N^o 56 North of Range N^o 51 West of the 10th Principal Meridian, Mich. is a true and correct copy of the original map of the same, as shown to the Surveyor General's Office, at Lansing, Mich., on the 10th day of June, 1856.

Surveyor General's Office
Lansing, Mich.

2 1/2 1/2