



# PLAT of Three Islands


in Lake Superior, Secs 2, 3, 11, Tp. 63 North, Range 39 West, Mich Meridian.

MICHIGAN.

Surveyed by John S. Miller, U.S. Deputy Surveyor, April 17<sup>th</sup> to May 16<sup>th</sup> 1862,  
under special instructions from the Com<sup>r</sup> G.L.O., dated March 25<sup>th</sup> 1862,

Scale 70 chs = 1 inch.

40-18  
40-18

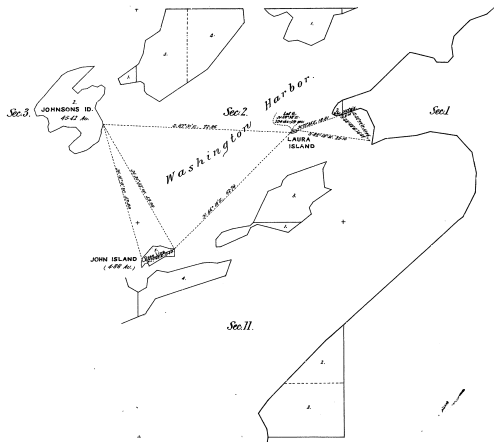

SUPERIOR

ISLE ROYALE

DEPARTMENT OF THE INTERIOR,  
General Land Office,  
Washington, D.C. May 17, 1862.

The above plat of "Three Islands" in Lake Superior, in Secs 2, 3, 11, Tp. 63 North, Range 39 West, Mich Meridian, Michigan, is a correct plat of a survey executed by John S. Miller, U.S. Deputy Surveyor, in pursuance of special instructions from the Commissioner of the General Land Office, bearing date March 25<sup>th</sup> 1862, and is strictly conformable to the field notes thereof on file in this office, which have been examined and approved.

L. J. Frank  
Acting Commissioner in Charge  
Surveyor General for Michigan