


Township *N 11* and Range *W 11* east of the *Rocky*

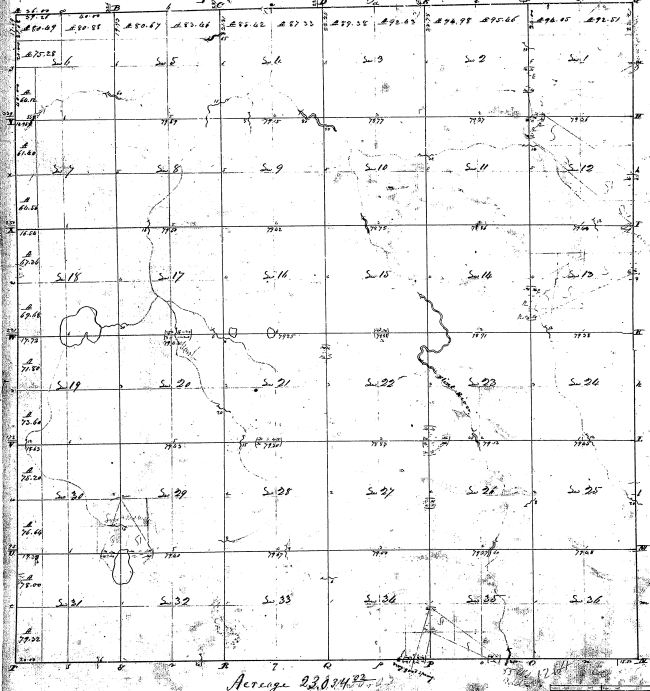

Acres 22,014.33

Conform to a plat with and instructions from *Edward J. Sawyer* of the United States Survey into the
 map of *Shaw* was laid out and surveyed the *Shaw* land (and *Shaw* by *Shaw* it had and
 much land bought both *Shaw* (and) to divide same as per plat on said plot and *Shaw* in the *Shaw* State in the
Shaw and returned with the plat into the surveyor general office. Dated the 20th day of *April* 1834

James Kelly S. J.

27-15

27-15