


Township N<sup>o</sup> 10 N, Range N<sup>o</sup> 10 E. Mer. (Mich.)

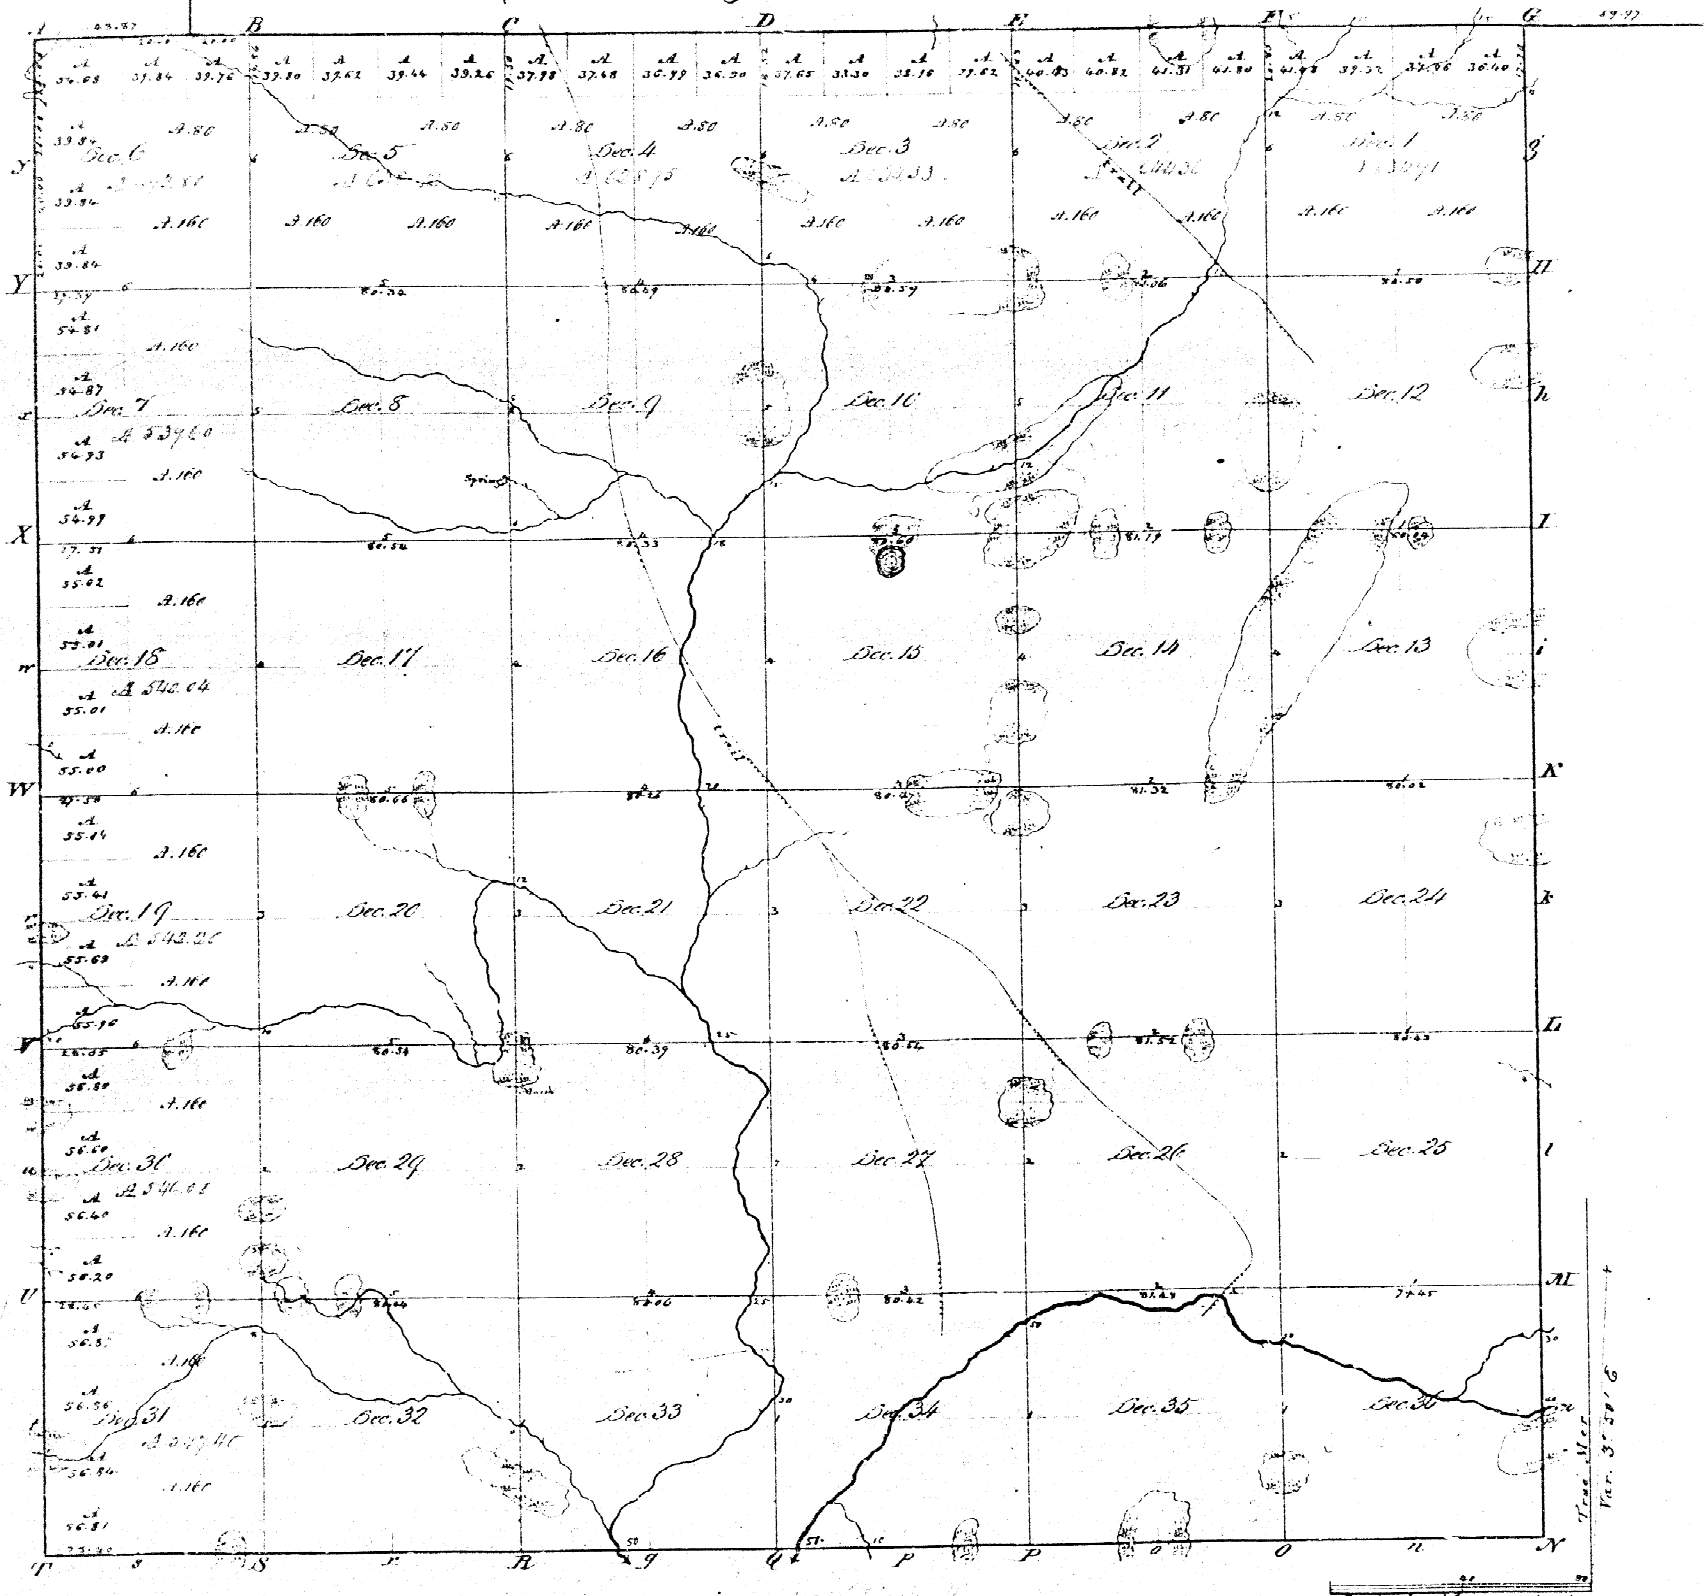

Survey	Name	Date	Rate of Contract	Acres	Value	Year
1 <sup>st</sup>	William Jankins	25 <sup>th</sup> Nov. 1833	59	17.413	1034	1835
2 <sup>d</sup>	Henry Parke	25 <sup>th</sup> Nov. 1833	28	75.00	1834	1834

The above Map of Township N<sup>o</sup> 10 N, Range N<sup>o</sup> 10 E. Mer. (Mich. Sec.) is strictly conformable to the field notes of the Survey thereof on file in this Office, which have been examined and approved.  
 Surveyor General's Office  
 Cincinnati, Mar. 20. 1835  
 A. T. Williams  
 Secy