


Township N. 7 south, Range N. 2 East Mer. (Mich. Ter.)

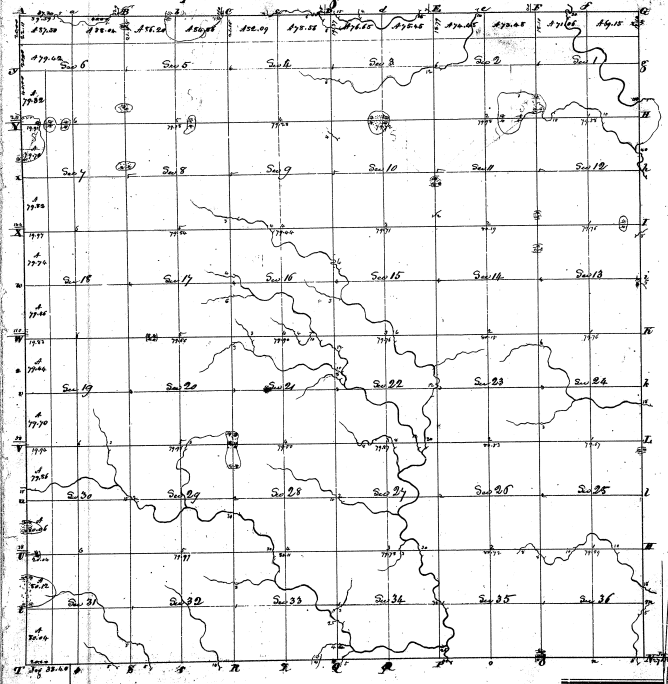

Total 4,212,000.00

Surveyed 1852  
G. S. Davis

Henry Parks D. V.

30-22

30-22