


Township 14th South, Range 10th East of 2nd Mer. (cont. Sec)

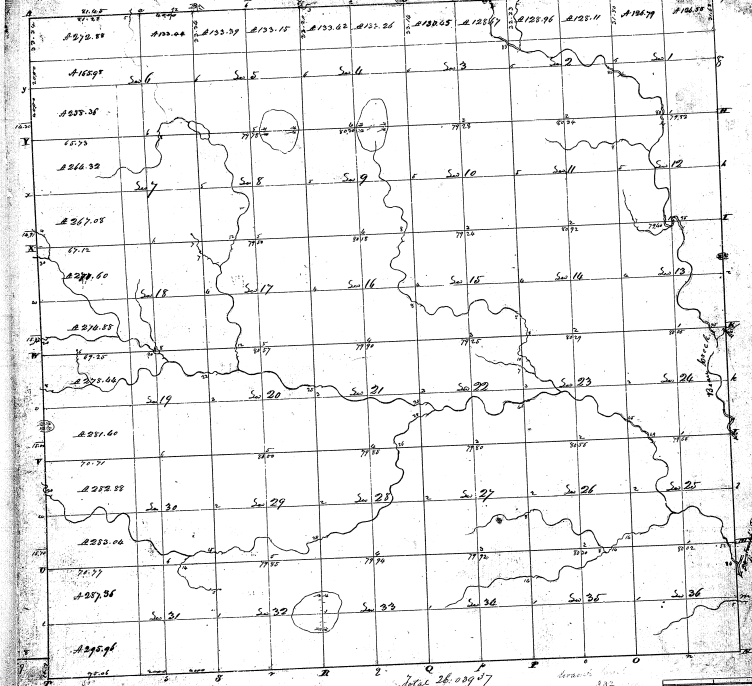

131

15-02

Present to a committee with and instructions from Charles J. Fox, Secretary General of the United States, bearing date the 11th day of June 1834, and under the above township, and do hereby state that it had been examined and found that the same is correct as an application on each part and inserted in the public state made thereof and returned with this plat into the office of the Surveyor General of the Territory of Missouri, bearing date the 11th day of May 1834.

Liba. Flour