


Correctional Survey

Township N° 48 N Range N° 10 W Mer. Mich.

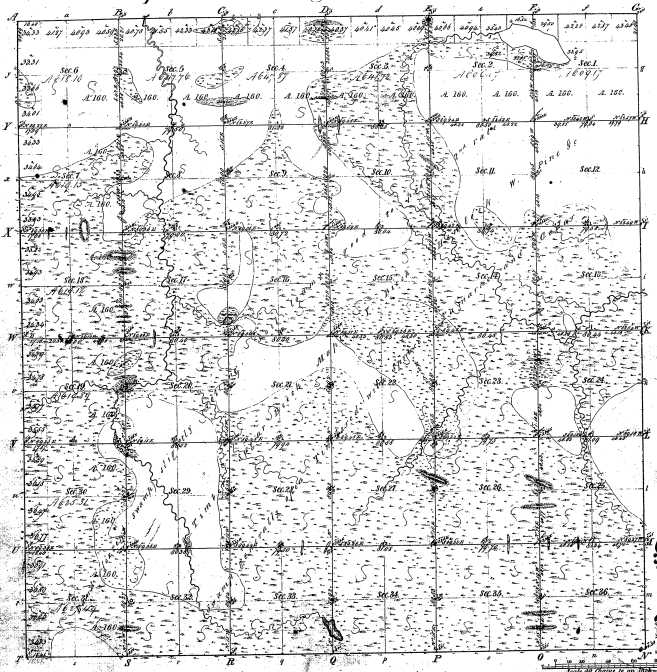

Boundaries of
 Public Courses 1818-18 Public Courses 1822-18 Public Courses 1826-18 Public Courses 1830-18

35-12

The records of the Lake in N° 10 W. R. 48 N. show an area of nearly Lake (1835) on both from the west of County Road.

This report is given on this not under the advice of the
 of the County and its name

Total number of Acres 22 881 65

Subdiv. Designated	By Whom Surveyed	Date of Contract	Amount of Survey	When Surveyed	How far and at what bearing from the last
Township 48 N	W. H. Burt	April 22 1841	18 20 1/2	Nov. 1841	
Subdivisions	Geo. H. Coates	May 22 1843	59 70 20	5 th Dec. 1843	

Be shown by of Township 48 N. R. 10 W. of Range 10 N. 48 N. of which the original boundaries of the same is already on file in the field notes of the survey of 1841 and 1843 which have been reviewed and approved by the Surveyors Office.

Surveyors Office
 Detroit, Mich. 11/1848

David Chapman

35-12