


Correctional Survey

Township N^o. 48 N. Range N^o. 11 W. Mer. Mich.

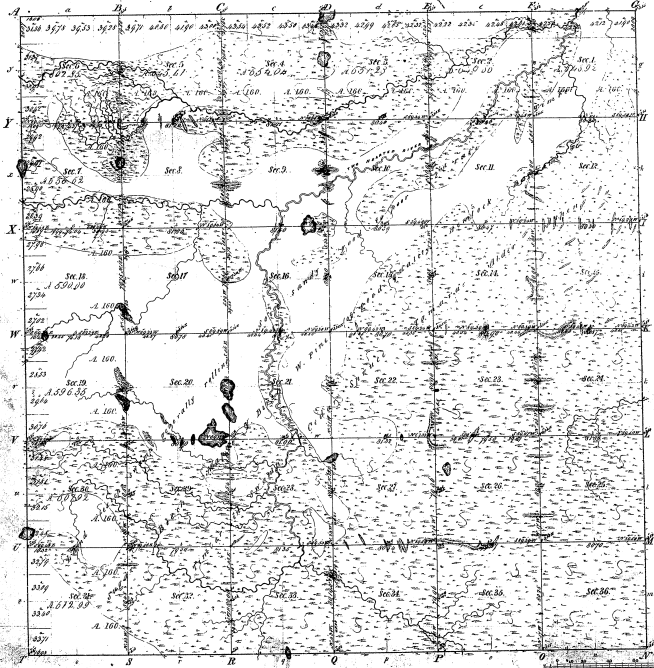

Meander's, et

Prove Courses 48226	Prove Courses 48225	Prove Courses 48224
3	11	

The meander and deposit on the 2d is correct. The relative position of the courses is the same.

35-11

Total number of Acres, 32,826.04

Survey designated	By whom surveyed	Date of contract	Amount of Survey	When Surveyed	How far any part is on the last line of road
Township lines	W. A. Dunt	April 1 st 1842	36 3/4 3/4	3 ^d June 1842	
Subdivisions	W. A. Dunt	May 2 ^d 1843	36 62 3/4	2 ^d June 1843	

The above Map of Township N. 48 N. of Range N. 11 W. is the original description of the Michigan Lands actually conformable to the full extent of the survey there on file in the office, which has been examined and approved.

Survey General Wm. C. Beardslee
 Detroit Nov 28 1851

Charles Chapman
 Surveyor