


Township 43 N Range 25 W Mer. Mich

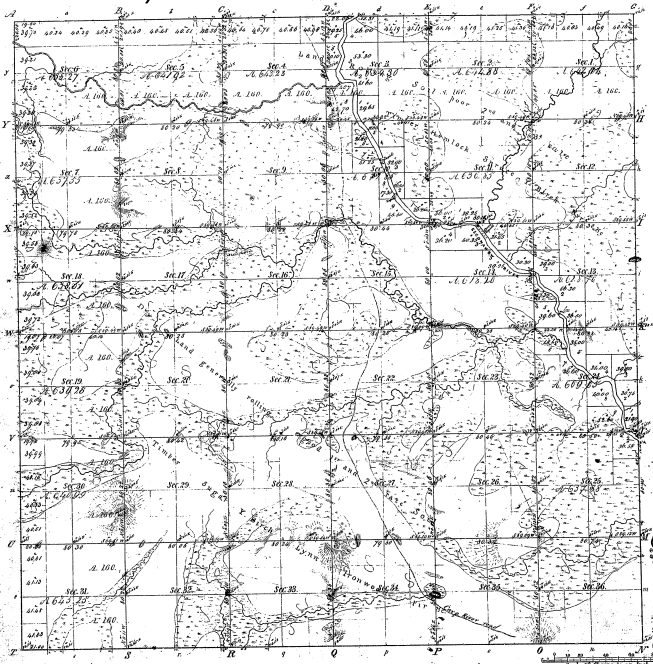

Boundaries of  
 1842  
 1843  
 1844  
35 20

38-26

Mean, East of the 1st.

Total number of Acres 22,951.55

Survey designated	By Whom Surveyed	Date of Contract	Amount of Survey	When Surveyed	Boundaries of the Survey
Traverse	M. M. Hall	June 10, 1852	66.57	St. Charles 1852	
Hydrographic	M. M. Hall	Bound 11, 1852			

The above Map of Township 43 North Range 25 West of the  
 Principal Meridian Michigan is hereby approved by the Field Notes  
 of the survey thereon on file in this Office, which have been examined and approved.  
 George General Office  
 Detroit May 22, 1862  
 S. C. Johnson  
 Surveyor