


Township N^o 32 N. Range N^o 27 W. Mer. Mich.

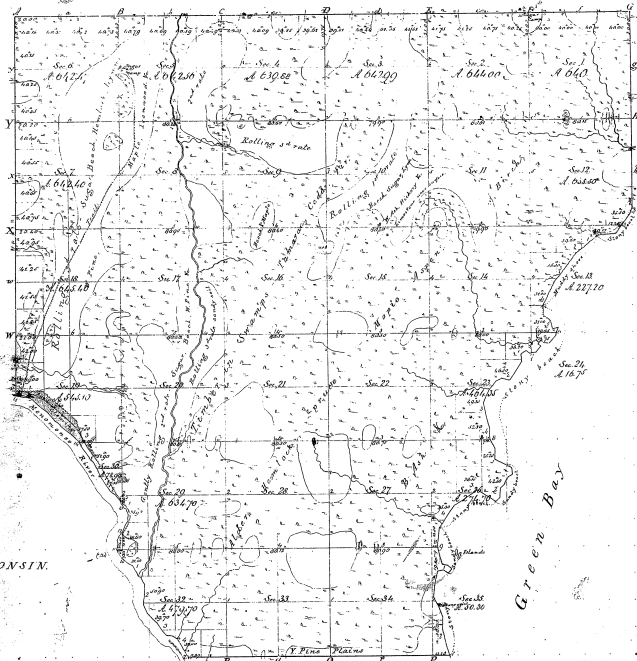

Section	Acres	Owner	Acres	Owner	Acres	Owner	
1	1.0400		2	1.0400		3	1.0400
4	1.0400		5	1.0400		6	1.0400
7	1.0400		8	1.0400		9	1.0400
10	1.0400		11	1.0400		12	1.0400
13	1.21710		14	1.21710		15	1.21710
16	1.21710		17	1.21710		18	1.21710
19	1.21710		20	1.0400		21	1.0400
22	1.0400		23	1.0400		24	1.0400
25	1.0400		26	1.21710		27	1.21710
28	1.21710		29	1.21710		30	1.21710
31	1.21710		32	1.21710		33	1.21710
34	1.21710		35	1.21710		36	1.21710

Total number of acres 18,463.20

Total number of acres 18,463.20

Survey	By Whom Surveyed	Date of Convey	Amount of Survey	When Surveyed	Area Claimed to be Section
1	John J. Hill	June 21, 1878	6.30	11	18.00
2	John J. Hill	22, 23, 24, 25, 26, 27, 28, 29, 30, 31, 32, 33, 34, 35, 36	50.36	02	33.00
3	John J. Hill	July 1, 1878	0.11	03	0.11

The above being Township N^o 32 North of Range N^o 27 West of the Principal Meridian, which is hereby confirmed, the said survey is hereby confirmed, and the same is hereby approved.

Surveyor General's Office
 Detroit, Dec 22, 1878
 L. C. Smith, Secy.

47-33