


Re-survey  
Township 1° 23 N Range N° 6 W Mer. Mich. 15-30

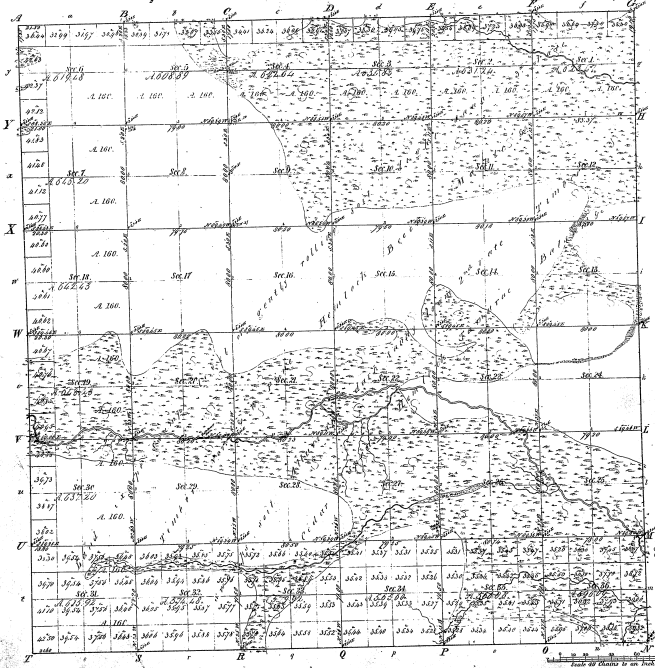

Measurements of					
Foot	Centesimal	Foot	Centesimal	Foot	Centesimal

15-30

Total number of Acres 22 611.70

Survey designated	By Whom Surveyed	Date of Commence	When Surveyed	Amount of land and sit of the town
Township Lines	John B. Williams	July 28th 1848	18 52 1/2	1837 1/2
Subdivisions	John B. Williams	March 26th 1848	24 29 1/2	23 30 1/2

The above Map of Township 15 23 N & R. 6 W of the Principal Meridian of Michigan is a true copy of the field notes of the survey thereon on file in the Office which have been examined and approved.

George S. Chaffee  
County Surveyor  
1887