


Re-survey
Township 1° 23 N Range 1° 7 W Mer. Mich.

Meanders of	Part	Course	Dist	Part	Course	Dist	Part	Course	Dist

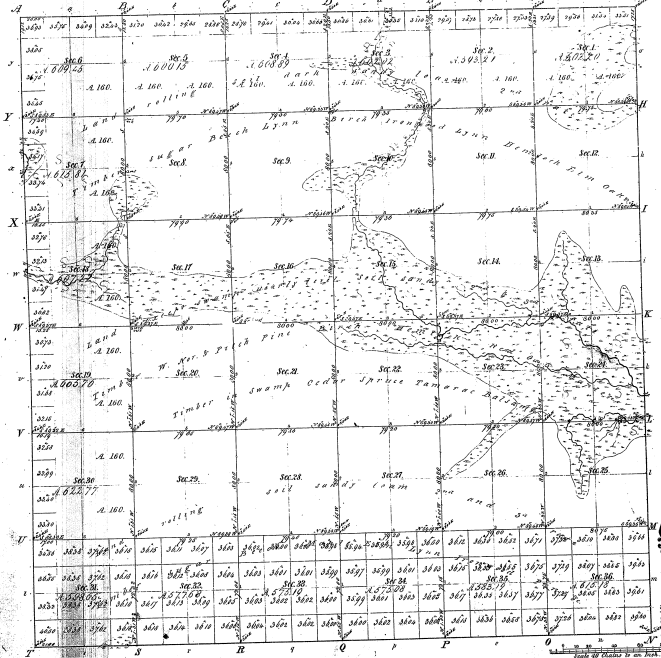

Total number of Acres 22 398 25

Survey designated	By whom surveyed	Date of Contract	Amount of Survey	When surveyed	Date of Sale	For what use
Timber	John Bevan	Sept 27 1850	4 71 22	1850	1850	1850
Indistinct	Thomas Whitlock	March 22 1850	58 71 22	1850	1850	1850

The above Map of Township 19 23 N of Range 19 7 W of the Michigan Meridian is hereby certified to be the correct and approved original as the same was taken and approved.

Charles Chapman
Surveyor

15-31