


Township 1^o 30. N. Range 1^o E. Mer. Mich.

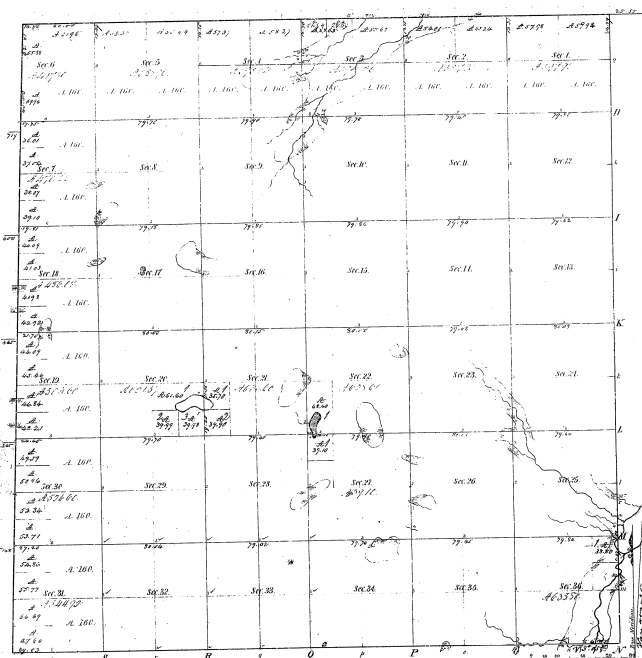

Minutes of Survey of 1837

1	1000	1000
2	1000	1000
3	1000	1000
4	1000	1000
5	1000	1000
6	1000	1000

21-1

Total number of acres 3157 58

Survey designated	By whom Surveyed	Date of Contract	Amount of Survey	Plan Surveyed	Money for said plan
Township 1 ^o 30. N. Range 1 ^o E.	James Alderson	1837	17,000	3-3-1837	3-3-1837
W. L.
W. L.

The above copy of Township 1^o 30. North of Range 1^o East of the Principal Meridian, Michigan, as truly conformable to the field notes of the survey filed on file in the Office, and has been examined and approved.

Surveyor General's Office
Ann Arbor, May 15th 1840

J. S. ...