


T. 2 N. R. 10 E

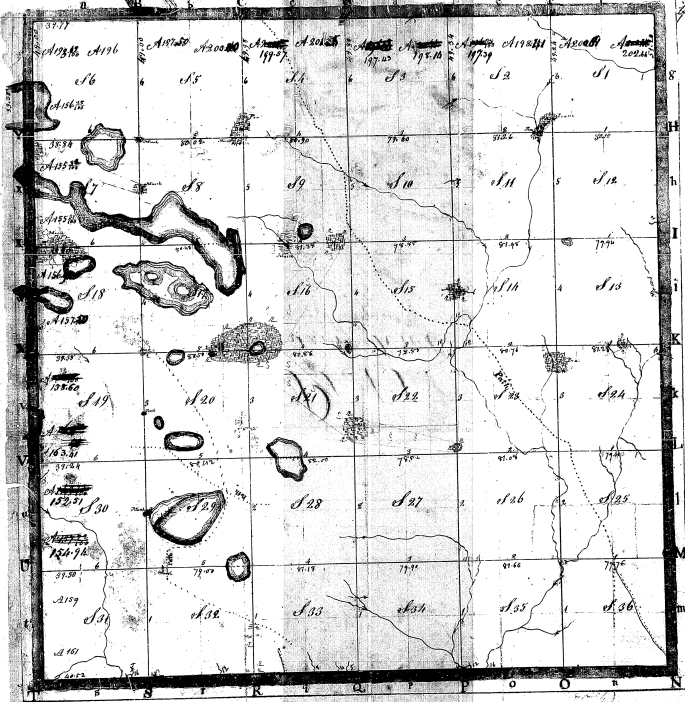

Township N<sup>o</sup> 2 North - Range N<sup>o</sup> 10 East.

Scale of  
Forty Chains to an Inch.

Pursuant to Contract with and Instructions from Edward Tiffin Esquire Surveyor General of the United States bearing date the 18<sup>th</sup> day of December 1816. I have measured laid out & surveyed the above described Township (to be) nearly equal to that of land, each of which bounds, both Natural and Artificial, as are particular in and Plain in position in the Returns upon thereof, and returned with the Plot into the Surveyor General's Office.

Witnessed this 28<sup>th</sup> day of May 1817.

Edwin J. S.