


Township N. V North, Range N. IX East of the Mer. (Mich. Ter.)

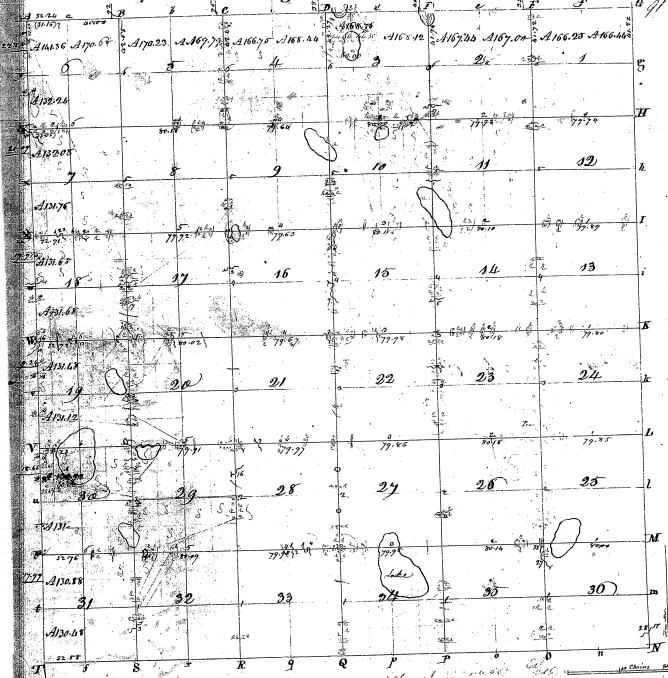

27-24

27-24

Substant to a contract with and instructions from Messrs. John Sawyer, General of the United States, bearing date the 26th day of February, in the year 1817, I have accordingly laid out and surveyed the above described Township, and do hereby certify that it had such marks and bounds both natural and artificial, as were represented on the said plan, and is divided into the field notes made thereof, and returned with this plat into the Surveyor General's Office
 Certified January 29th 1818. Saml. Worcester Secy.