


Township N^o 51 N. Range N^o 41 W. Mer: Mich

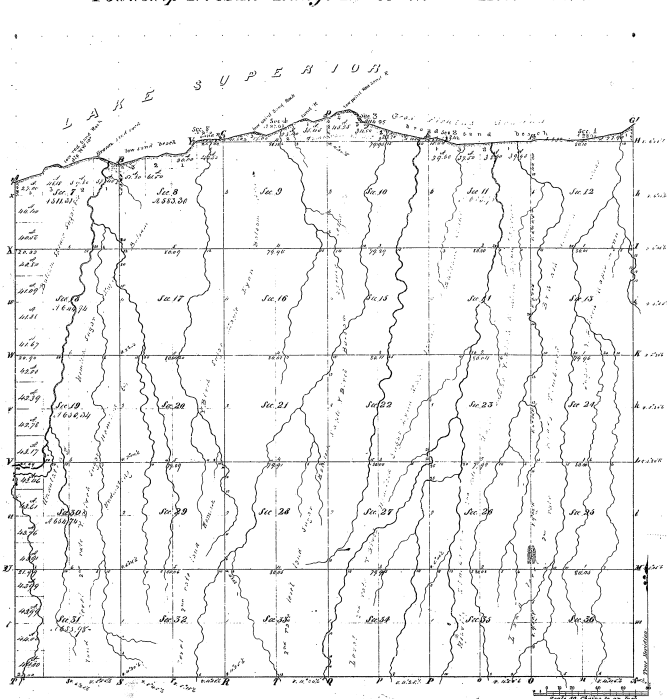

41-33

41-33

Standard of
Foot
Chain
Section
Course
Mile
Course
Foot

Total number of Acres 10979.15

Survey Original	By Whom Surveyed	Date of Conveyance	Amount of Acres	When Surveyed	When Conveyed to the Owner
Boreing line	Wm. A. Johnson	Thurs. 31st May	12 15 50	8th June 1857	
Subdivisions	By order of J. M. Johnson	18th 22d	52 72 22	8th June 1857	

This above Map of Township N^o 51 N. Range N^o 41 W. Mer: Mich. Prepared by William A. Johnson, as a public conveyance to the full and entire survey thereof on file in this office, and has been examined and approved.

Surveyor General's Office
Detroit, Mich. Oct 16, 1857

J. M. Lyon, Secy. Genl.