


Township No. 17 North, Range No. 10 West Mex. Mic.

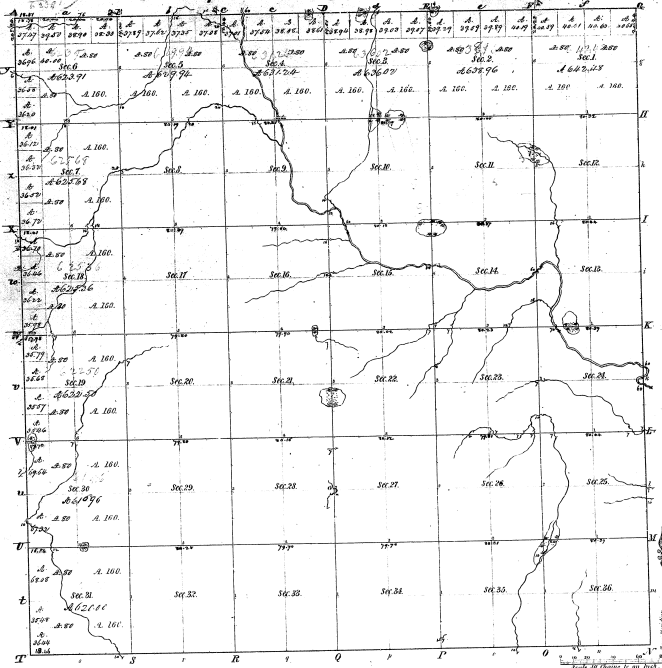

| Part | Course | Dist | Part | Course | Dist | Part | Course | Dist |
|------|--------|------|------|--------|------|------|--------|------|
| | | | | | | | | |
| | | | | | | | | |
| Total number of Acres 2,291.85 | | | | | |
|--------------------------------|------------------|------------------|------------------|---------------|--------------------|
| Survey designated | By whom surveyed | Date of contract | Amount of survey | When surveyed | When first set out |
| Township lines | John Holmgren | Jan. 12, 1837 | 36 100 100 | 1837 | 1837 |
| Subdivisions | Same | Jan. 30, 1838 | 39 25 36 | 1838 | 1839 |

The above copy of Township No. 17 N. of Range No. 10 W. of the 3rd Principal Meridian, Michigan, is hereby certified to be a true and correct copy of the survey thereon, in full and true copy, which have been examined and approved by the Surveyors General of the State of Michigan, Dec. 8, 1839.

J. A. Sibley Surveyor General