


Township 1° 32' N. Range 1° 31' W. Mex. Mich.

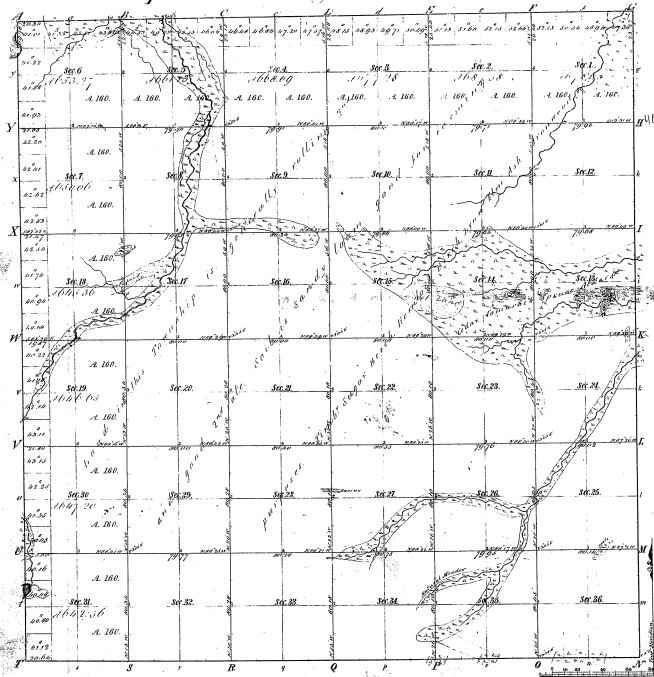

Mileage, 1/4		
Public Course 1814	Public Course 1815	Public Course 1816
	18	23

18-23

Total number of Acres 23258.13

Survey Disposed	By Whom Received	Date of Condit	Amount of Survey	When Surveyed	How? for and by whom the Gov. Land Co. used
Principal Store	John Mitchell	June 15 1816	16 22 27	2 <sup>d</sup> Oct 1816	
Subdivided	William Shaw	April Dec 1816	16 22 27	1 <sup>st</sup> Oct 1816	

The above copy of Township 1° 32' North of Range 1° 31' West of the Principal Meridian Michigan is strictly conformable to the field notes of the survey thereof on file in this Office, which have been examined and approved.  
 Surveyor General's Office  
 Detroit Jan 22 1850  
 Charles Fisher Sur Gen.