


Township N. VII North, Range N. XV West Mer. (Mc.Ter.)

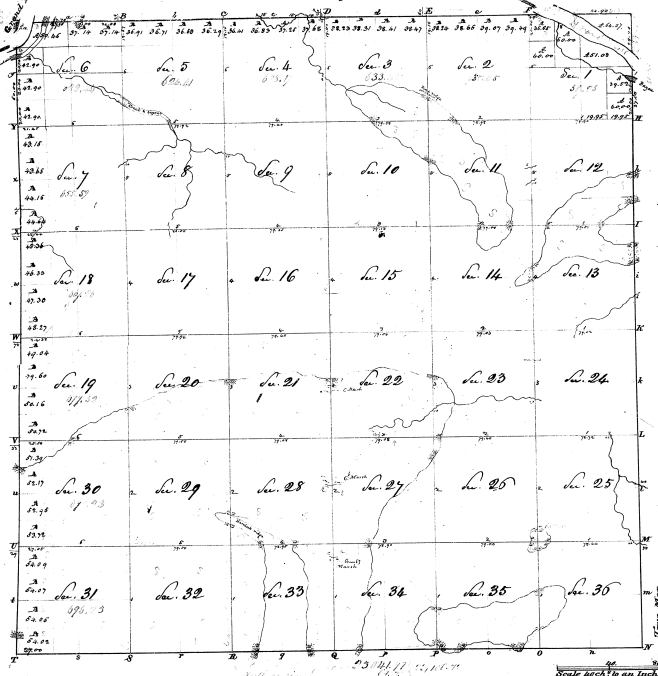

Measure 50	
Round 2000	
Half Section 10.00	
in Section One	
1. 137.77	3.57
2. 108.77	13.17
3. 189.77	52.57
4. 288.77	122.27
in Section six	
1. 119.77	5.57
2. 109.77	11.57
3. 288.77	6.57
Right hand down them	
in Sec. 4	
1. 158.00	23.00
2. 152.00	26.00
3. 289.00	6.00
Right hand down them	
in Sec. 6	
1. 158.00	3.57

8-10 175
8-15

Survey District	By whom surveyed	Date of Survey	Amount of land surveyed	When surveyed	By whom surveyed
Barren River	L. S. Ligon	12. Nov. 1830	61.45.34	May 1832	W. H. H. 1833
Barren River	W. H. H.	1833	1. 67.32	1. 1837	3. 1838
Barren River	John H. H.	1837	57.37	1. 1837	2. 1837

The above maps of Township N. VII North of Range N. XV West of the Meridian, Michigan Co. is the copy made to the field party of the Survey thereof, on file in this office, which have been examined and approved.
Surveyor General's Office
C. A. Bennett 1838
M. T. Williams
Secy.