


Township N. IX North, Range N. XVI East Sec. (Aerial, Tex.)

116

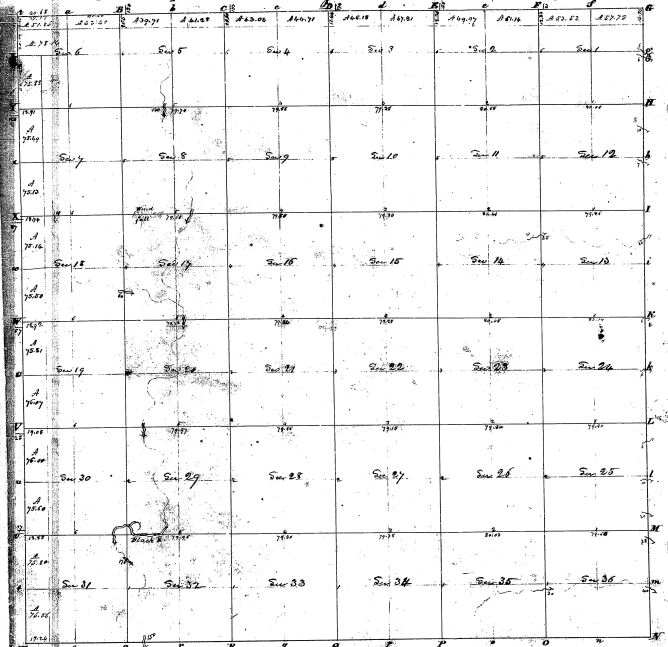

26-7

26-7

Plat N. 22. vol 48

Consistent to a contract with said instructions from Governor Jefferson through General of the United States, bearing date the 20th of July 1820, and having the above described Township and its parts that it has been made and burned both National and Artificial in one separate on said plat and described in the first note on the map, and returned with the plat into the Surveyor General's office - said plat this 8th day of Dec. 1822

James G. ...