


Township 1<sup>st</sup> N. R. Range 13<sup>th</sup> E. Mer. Mich.

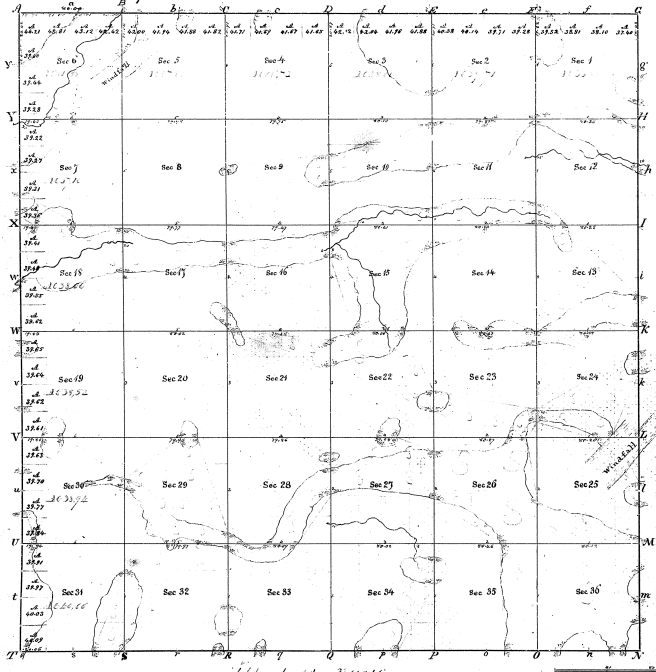

25-22  
1911  
25-22

Total number of acres 2560.00

Survey description	By whom done?	Date of certificate	Acres	Amount	Per cent
Johnson	R. Washburn	11 July 1836	600.00	23.44	9.15
Johnson	Henry Clarke	25 Feb 1833	600.00	23.44	9.15
Johnson	Henry Clarke	25 Feb 1833	1900.00	73.56	28.70

This above map of Township 1<sup>st</sup> N. Range 13<sup>th</sup> E. Mer. (Mich.) is fully conformable to the field notes of the survey thereof, on file in this office, which have been examined and approved.  
Surveyor General's Office  
Ann Arbor, Mich. 20<sup>th</sup> Dec 1835  
M. T. Nelson  
Sur. Gen.