


Township N. 1 South, Range N. 17 West Mer. (W. 1st.)

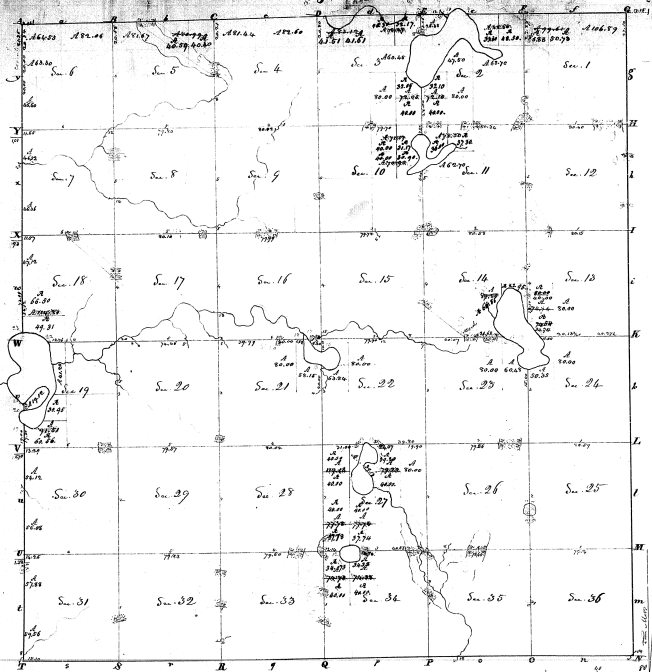

Surveyed

Surveyed in January 1830 by Robert Clark for S.S.

2-1

Quantity		Quantity	
Acres	Area	Acres	Area
1/2 NW 1	146 39	SW 1	320
SW 1	30	NW 1	41 20
1/2 NW 2	99 57	SW 2	31 57
SW 2	30	NW 2	31 57
1/2 NW 3	320	SW 3	600
SW 3	28 30	NW 3	8 30
1/2 NW 4	47 20	SW 4	31 57
SW 4	30	NW 4	30
1/2 NW 5	25 28	SW 5	160
SW 5	30	NW 5	220
1/2 NW 6	70 10	SW 6	30
SW 6	281 67	NW 6	63 20
1/2 NW 7	20 10	SW 7	30
SW 7	20 10	NW 7	220
1/2 NW 8	53 10	SW 8	60 4 9
SW 8	30	NW 8	30
1/2 NW 9	20 10	SW 9	160
SW 9	20 10	NW 9	30
1/2 NW 10	160	SW 10	320
SW 10	30	NW 10	160
1/2 NW 11	320	SW 11	30
SW 11	30	NW 11	30 35
1/2 NW 12	320	SW 12	30
SW 12	30	NW 12	320
1/2 NW 13	30	SW 13	600
SW 13	30	NW 13	320
1/2 NW 14	30	SW 14	30
SW 14	30	NW 14	30
1/2 NW 15	30	SW 15	30
SW 15	30	NW 15	30
1/2 NW 16	30	SW 16	30
SW 16	30	NW 16	30
1/2 NW 17	30	SW 17	30
SW 17	30	NW 17	30
1/2 NW 18	30	SW 18	30
SW 18	30	NW 18	30
1/2 NW 19	30	SW 19	30
SW 19	30	NW 19	30
1/2 NW 20	30	SW 20	30
SW 20	30	NW 20	30
1/2 NW 21	30	SW 21	30
SW 21	30	NW 21	30
1/2 NW 22	30	SW 22	30
SW 22	30	NW 22	30
1/2 NW 23	30	SW 23	30
SW 23	30	NW 23	30
1/2 NW 24	30	SW 24	30
SW 24	30	NW 24	30
1/2 NW 25	30	SW 25	30
SW 25	30	NW 25	30
1/2 NW 26	30	SW 26	30
SW 26	30	NW 26	30
1/2 NW 27	30	SW 27	30
SW 27	30	NW 27	30
1/2 NW 28	30	SW 28	30
SW 28	30	NW 28	30
1/2 NW 29	30	SW 29	30
SW 29	30	NW 29	30
1/2 NW 30	30	SW 30	30
SW 30	30	NW 30	30
1/2 NW 31	30	SW 31	30
SW 31	30	NW 31	30
1/2 NW 32	30	SW 32	30
SW 32	30	NW 32	30
1/2 NW 33	30	SW 33	30
SW 33	30	NW 33	30
1/2 NW 34	30	SW 34	30
SW 34	30	NW 34	30
1/2 NW 35	30	SW 35	30
SW 35	30	NW 35	30
1/2 NW 36	30	SW 36	30
SW 36	30	NW 36	30
1/2 NW 37	30	SW 37	30
SW 37	30	NW 37	30
1/2 NW 38	30	SW 38	30
SW 38	30	NW 38	30
1/2 NW 39	30	SW 39	30
SW 39	30	NW 39	30
1/2 NW 40	30	SW 40	30
SW 40	30	NW 40	30
1/2 NW 41	30	SW 41	30
SW 41	30	NW 41	30
1/2 NW 42	30	SW 42	30
SW 42	30	NW 42	30
1/2 NW 43	30	SW 43	30
SW 43	30	NW 43	30
1/2 NW 44	30	SW 44	30
SW 44	30	NW 44	30
1/2 NW 45	30	SW 45	30
SW 45	30	NW 45	30
1/2 NW 46	30	SW 46	30
SW 46	30	NW 46	30
1/2 NW 47	30	SW 47	30
SW 47	30	NW 47	30
1/2 NW 48	30	SW 48	30
SW 48	30	NW 48	30
1/2 NW 49	30	SW 49	30
SW 49	30	NW 49	30
1/2 NW 50	30	SW 50	30
SW 50	30	NW 50	30
1/2 NW 51	30	SW 51	30
SW 51	30	NW 51	30
1/2 NW 52	30	SW 52	30
SW 52	30	NW 52	30
1/2 NW 53	30	SW 53	30
SW 53	30	NW 53	30
1/2 NW 54	30	SW 54	30
SW 54	30	NW 54	30
1/2 NW 55	30	SW 55	30
SW 55	30	NW 55	30
1/2 NW 56	30	SW 56	30
SW 56	30	NW 56	30
1/2 NW 57	30	SW 57	30
SW 57	30	NW 57	30
1/2 NW 58	30	SW 58	30
SW 58	30	NW 58	30
1/2 NW 59	30	SW 59	30
SW 59	30	NW 59	30
1/2 NW 60	30	SW 60	30
SW 60	30	NW 60	30
1/2 NW 61	30	SW 61	30
SW 61	30	NW 61	30
1/2 NW 62	30	SW 62	30
SW 62	30	NW 62	30
1/2 NW 63	30	SW 63	30
SW 63	30	NW 63	30
1/2 NW 64	30	SW 64	30
SW 64	30	NW 64	30
1/2 NW 65	30	SW 65	30
SW 65	30	NW 65	30
1/2 NW 66	30	SW 66	30
SW 66	30	NW 66	30
1/2 NW 67	30	SW 67	30
SW 67	30	NW 67	30
1/2 NW 68	30	SW 68	30
SW 68	30	NW 68	30
1/2 NW 69	30	SW 69	30
SW 69	30	NW 69	30
1/2 NW 70	30	SW 70	30
SW 70	30	NW 70	30
1/2 NW 71	30	SW 71	30
SW 71	30	NW 71	30
1/2 NW 72	30	SW 72	30
SW 72	30	NW 72	30
1/2 NW 73	30	SW 73	30
SW 73	30	NW 73	30
1/2 NW 74	30	SW 74	30
SW 74	30	NW 74	30
1/2 NW 75	30	SW 75	30
SW 75	30	NW 75	30
1/2 NW 76	30	SW 76	30
SW 76	30	NW 76	30
1/2 NW 77	30	SW 77	30
SW 77	30	NW 77	30
1/2 NW 78	30	SW 78	30
SW 78	30	NW 78	30
1/2 NW 79	30	SW 79	30
SW 79	30	NW 79	30
1/2 NW 80	30	SW 80	30
SW 80	30	NW 80	30
1/2 NW 81	30	SW 81	30
SW 81	30	NW 81	30
1/2 NW 82	30	SW 82	30
SW 82	30	NW 82	30
1/2 NW 83	30	SW 83	30
SW 83	30	NW 83	30
1/2 NW 84	30	SW 84	30
SW 84	30	NW 84	30
1/2 NW 85	30	SW 85	30
SW 85	30	NW 85	30
1/2 NW 86	30	SW 86	30
SW 86	30	NW 86	30
1/2 NW 87	30	SW 87	30
SW 87	30	NW 87	30
1/2 NW 88	30	SW 88	30
SW 88	30	NW 88	30
1/2 NW 89	30	SW 89	30
SW 89	30	NW 89	30
1/2 NW 90	30	SW 90	30
SW 90	30	NW 90	30
1/2 NW 91	30	SW 91	30
SW 91	30	NW 91	30
1/2 NW 92	30	SW 92	30
SW 92	30	NW 92	30
1/2 NW 93	30	SW 93	30
SW 93	30	NW 93	30
1/2 NW 94	30	SW 94	30
SW 94	30	NW 94	30
1/2 NW 95	30	SW 95	30
SW 95	30	NW 95	30
1/2 NW 96	30	SW 96	30
SW 96	30	NW 96	30
1/2 NW 97	30	SW 97	30
SW 97	30	NW 97	30
1/2 NW 98	30	SW 98	30
SW 98	30	NW 98	30
1/2 NW 99	30	SW 99	30
SW 99	30	NW 99	30
1/2 NW 100	30	SW 100	30
SW 100	30	NW 100	30
1/2 NW 101	30	SW 101	30
SW 101	30	NW 101	30
1/2 NW 102	30	SW 102	30
SW 102	30	NW 102	30
1/2 NW 103	30	SW 103	30
SW 103	30	NW 103	30
1/2 NW 104	30	SW 104	30
SW 104	30	NW 104	30
1/2 NW 105	30	SW 105	30
SW 105	30	NW 105	30
1/2 NW 106	30	SW 106	30
SW 106	30	NW 106	30
1/2 NW 107	30	SW 107	30
SW 107	30	NW 107	30
1/2 NW 108	30	SW 108	30
SW 108	30	NW 108	30
1/2 NW 109	30	SW 109	30
SW 109	30	NW 109	30
1/2 NW 110	30	SW 110	30
SW 110	30	NW 110	30
1/2 NW 111	30	SW 111	30
SW 111	30	NW 111	30
1/2 NW 112	30	SW 112	30
SW 112	30	NW 112	30
1/2 NW 113	30	SW 113	30
SW 113	30	NW 113	30
1/2 NW 114	30	SW 114	30
SW 114	30	NW 114	30
1/2 NW 115	30	SW 115	30
SW 115	30	NW 115	30
1/2 NW 116	30	SW 116	30
SW 116	30	NW 116	30
1/2 NW 117	30	SW 117	30
SW 117	30	NW 117	30
1/2 NW 118	30	SW 118	30
SW 118	30	NW 118	30
1/2 NW 119	30	SW 119	30
SW 119	30	NW 119	30
1/2 NW 120	30	SW 120	30
SW 120	30	NW 120	30
1/2 NW 121	30	SW 121	30
SW 121	30	NW 121	30
1/2 NW 122	30	SW 122	30
SW 122	30	NW 122	30
1/2 NW 123	30	SW 123	30
SW 123	30	NW 123	30
1/2 NW 124	30	SW 124	30
SW 124	30	NW 124	30
1/2 NW 125	30	SW 125	30
SW 125	30	NW 125	30
1/2 NW 126	30	SW 126	30
SW 126	30	NW 126	30
1/2 NW 127	30	SW 127	30
SW 127	30	NW 127	30
1/2 NW 128	30	SW 128	30
SW 128	30	NW 128	30
1/2 NW 129	30	SW 129	30
SW 129	30	NW 129	30
1/2 NW 130	30	SW 130	30
SW 130	30	NW 130	30
1/2 NW 131	30	SW 131	30
SW 131	30	NW 131	30
1/2 NW 132	30	SW 132	30
SW 132	30	NW 132	