


Township N^o III south, Range N^o IV East of Mer (Mich^otan)

27

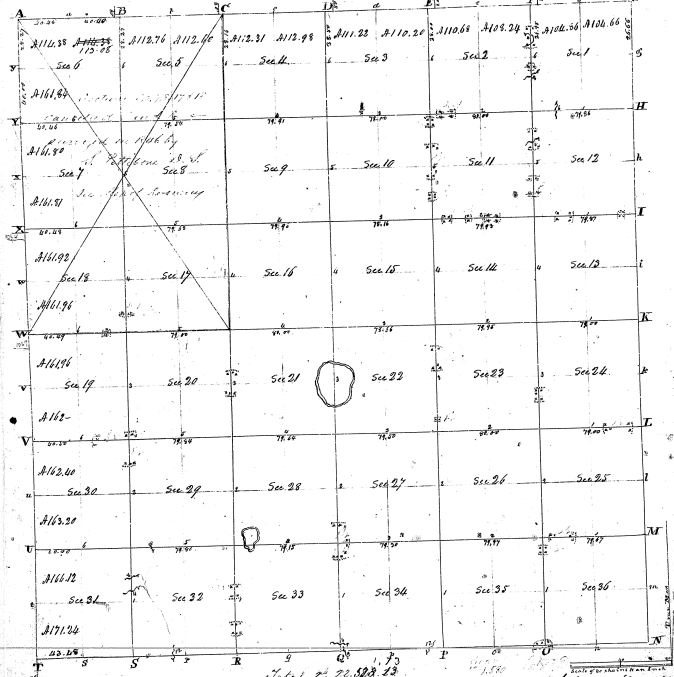

30-4


30-9

Pursuant to a contract with an intention from ^{22, 23, 24} Oliver H. Brown, General of the United States land
 I have advanced, laid out and surveyed the above described Township, and as
 hereby certify that it has such marks and bearings both natural and artificial as are expressed on said plat
 and described in the following made there as mentioned in the title of this plat into the Survey General's Office,
 and deposited in the file of said Township on this 4th day of Nov. 1849.

Joseph James

30-1

30-9 (2)

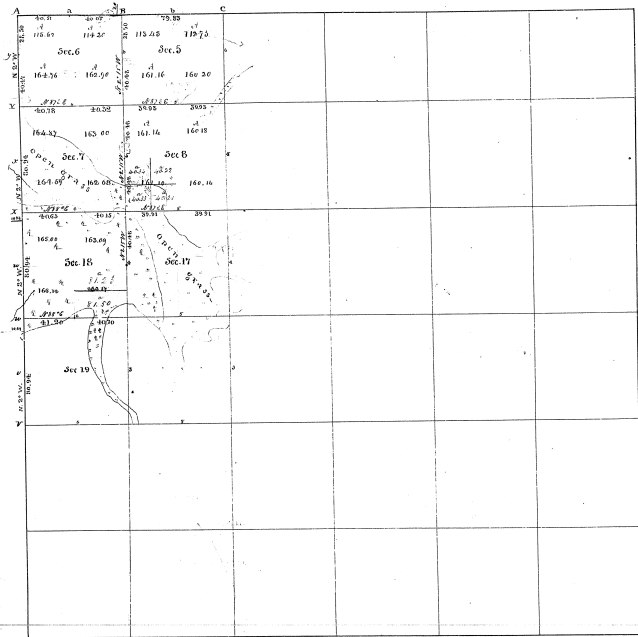

Surveyed by Geo. W. Collins. Apr 26th 1866

The above Map of a part of Township N^o 5 S of Range N^o 4 E
of the present Meridian Michigan is strictly confidential.
to the first date, and clearence of the card and scenery
therein file in this office which have been examined and approved
Springer General Office
Detroit Oct 6th 1866

Lucius Lyon,
Adj. Genl