


Township N. 2. South, Range N. IX East of the Mer. (Michigan Ter.)

79

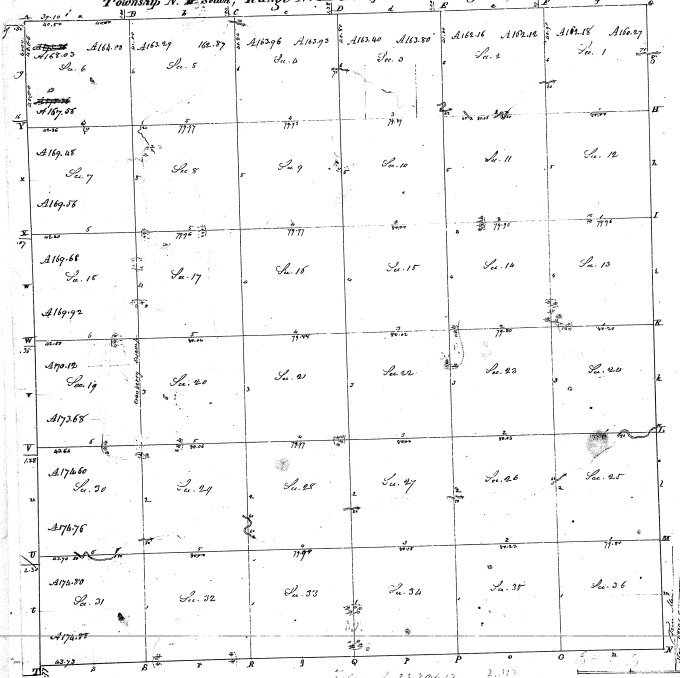

31-11

31-11

Return to a certain well, and instructions from Board of Public Lands, Surveyor General of the United States, bearing date the 25th day of May 1866, I have examined and out and surveyed the above described township, and as hereby certified that it had been made and bounded both natural and artificial as an independent one and that, and as such, and the field notes made thereon and returned with this sheet into the office of the Surveyor General.

Witness my hand and seal this 25th day of May 1877

*[Signature]*