


Township N° III South, Range N° VIII East of Meridian (Wick, Ill.)

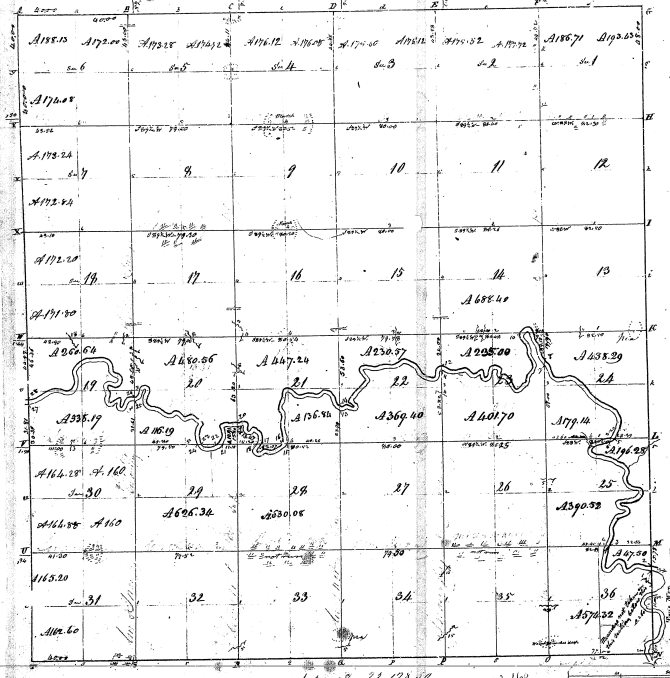

31-13

31-13

Pursuant to a contract with the instructions from Edward J. Manger, Agent of the United States, bearing date the 10th day of May 1891, I have examined, laid out and surveyed the above described township, to wit: hereby certify that it has such bounds, and bears both natural and artificial points as are represented on said plat and described in the office files under which I obtained the plat into the Survey General Office.

Certified this 18th day of September 1893.

J. M. Wampler, Del.