


25-15

193

25-15

Township N<sup>o</sup> 15 N Range N<sup>o</sup> 13 E Mer Mich.

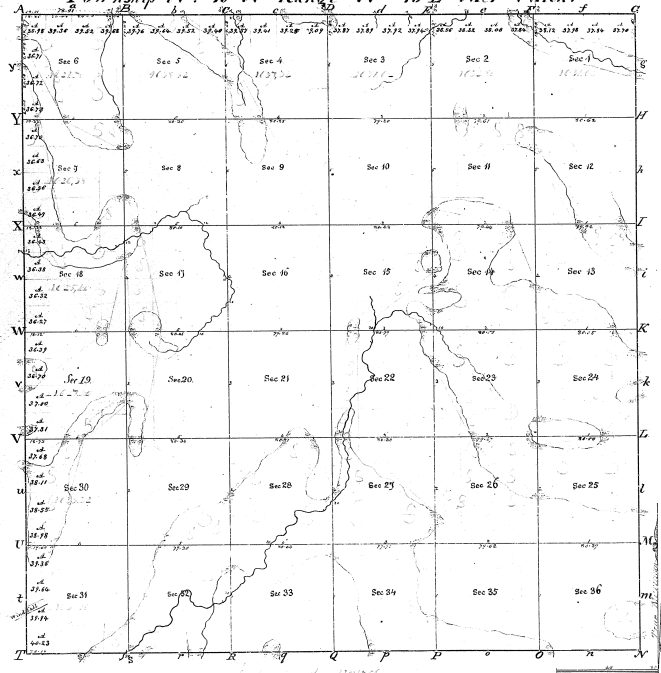

Survey District	Section	Acres	Acres	Acres	Acres	Acres
Section 1	Section 2	Section 3	Section 4	Section 5	Section 6	Section 7
Section 8	Section 9	Section 10	Section 11	Section 12	Section 13	Section 14
Section 15	Section 16	Section 17	Section 18	Section 19	Section 20	Section 21
Section 22	Section 23	Section 24	Section 25	Section 26	Section 27	Section 28
Section 29	Section 30	Section 31	Section 32	Section 33	Section 34	Section 35
Section 36						

The above map of Township N<sup>o</sup> 15 N, Range N<sup>o</sup> 13 E, Mer Mich. 1830, all the sections therein are actually conformable to the field notes of the Survey of the said Township, which have been examined & approved by the Surveyor General's Office, M. T. Williams, Surveyor General, Nov. 20, 1835.