


Township 1° 45' N. Range 1° 22' W. Mer. Mich.

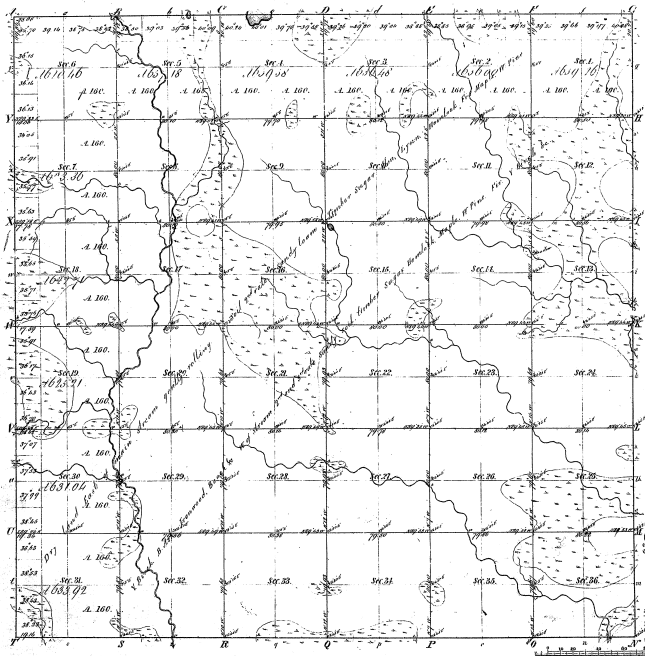

Total number of acres 22946.20

Survey designated	By Whom Surveyed	Date or Date	Amount of Acres	When Surveyed
Township - Mer.	William A. Miller	April 18 1851	31 57 46	1851
Subdivisions	A. Miller & Co.	April 18 1852	59 66 77	1852

The above Map of Township 19 65 North of Range 19 22 West of the
 Principal Meridian Michigan is a correct and complete & the full copy
 of the survey thereon kept in the office which has been examined and approved
 George Conant, Clerk
 Charles H. H. H. H.

Sealed & Signed
 George Conant, Clerk

Correct Copy

Meanders of	Point Courses	Distances	Point Courses	Distances
38-9				

38-9