


Township 1° 47' N. Range 3° 17' W. Mer. Mich.

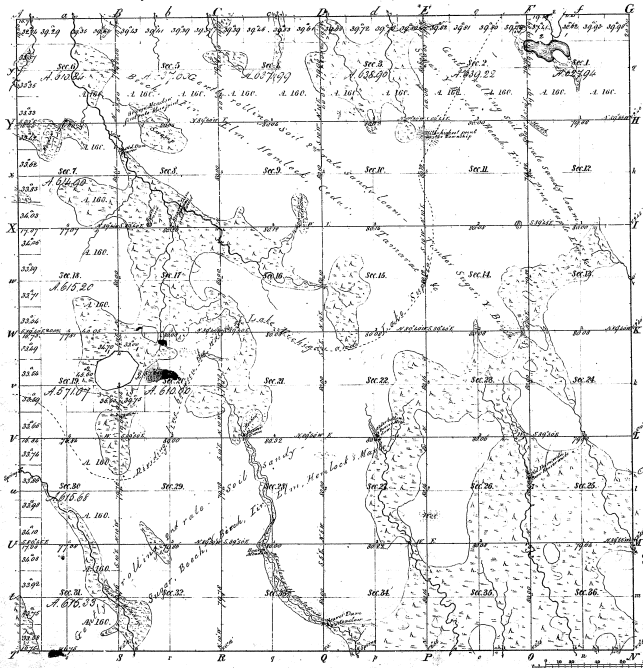

Menture of		Acres		Acres		Acres	
Tract	Course	Value	Tract	Course	Value	Tract	Course
3118							
No. 1							
No. 2							
No. 3							
No. 36							

378

Total number of acres 22,704.73

Survey designated	By whom surveyed	Date of Contract	Amount of Survey	When Surveyed	When made and sold to the State
Township - lots	Wm. E. Black	Apr. 1. 1864	10. 52. 73	2nd June 1864	2nd June 1864
Subdivisions	William Love	Apr. 20. 1864	31. 60. 57	1st June 1864	1st June 1864

The above Map of Township 1° 47' North of Range 3° 17' West of the Principal Meridian Michigan, is strictly conformable to the field notes of the survey thereof on file in this Office, which have been examined and approved.

Surveyor General's Office
Detroit March 5/1861

Charles Wells
Superintendent

Register