


Township 47th N. Range 31st W. Mer. Mich.

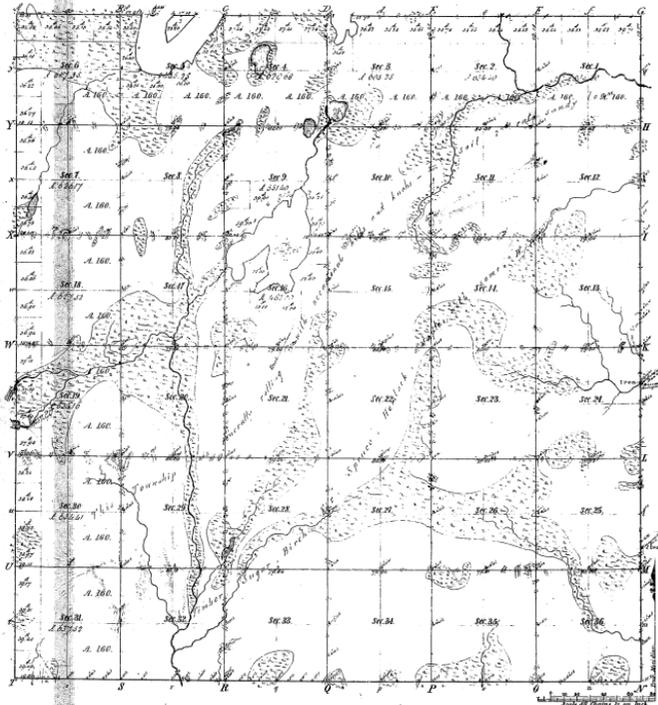

Merrill of			
Pratt Course 1824	Pratt Course 1824	Pratt Course 1824	Pratt Course 1824
15			
15			
45-15			
Total Acres 7 20 50			

Total number of Acres 7 20 50

Survey designated	By Whom surveyed	Date of Commencement	Amount of Survey	When Surveyed	How Surveyed
Township 47 th N.	W. M. M. M.	1824	7 20 50	1824	1824
Subdivisions	John B. B.	1824	7 20 50	1824	1824

The above copy of Township 47th N. Range 31st W. Mer. Mich. is a true and correct copy of the original Meridian Map as shown in the field notes of the survey, thereon for the use of the office, and has been examined and approved.

Surveyor General's Office
Detroit, Mich. 1824

Lucius Lyon, Surveyor

