


Township N<sup>o</sup> 46. N. Range N<sup>o</sup> 2 W. Mer. Mich.

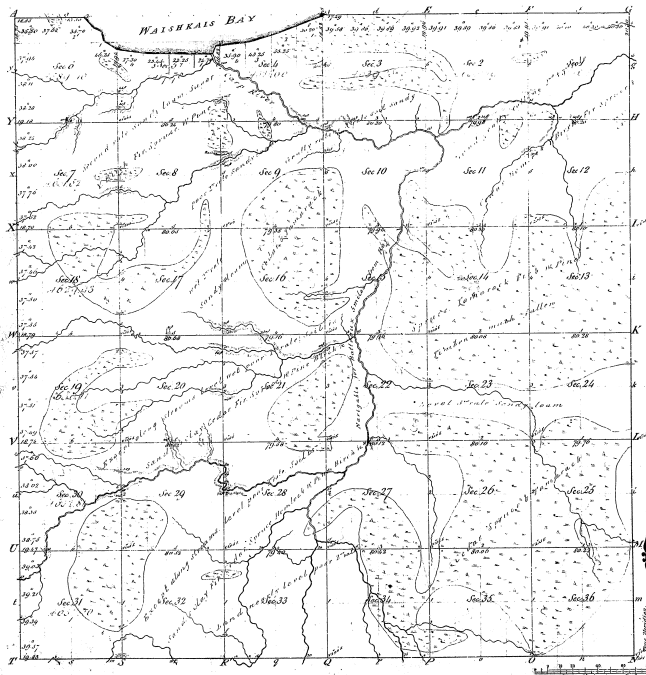

Boundaries of  
Township N<sup>o</sup> 46. N. Range N<sup>o</sup> 2 W. Mer. Mich.

34-15

34-15

Mand. E. L. 7/72

Total number of Acres 2167.82

Survey designated.	By Whom Surveyed	Date of Center	Amount of Survey Ac. 100' 100'	When Surveyed	When Closed or Not Closed & why
Township lines.	W. G. Brown & others	Jan. 11. 1856	12. 50. 33	1 <sup>st</sup> June 1856	
Subdivisions.	N. H. & M. L. Jones	June 29. 1856	61. 71. 102	3 <sup>rd</sup> June 1856	

The above Map of Township N<sup>o</sup> 46 North of Range 1<sup>st</sup> 2 West of the 1<sup>st</sup> Meridian & 2<sup>nd</sup> West of the 1<sup>st</sup> Meridian is a correct copy of the survey shown on file in this Office, which have been examined and approved.

Surveyor General's Office Charles A. Allen  
Detroit, Mar. 16. 1856

Sur. Gen. Allen

