


Re-survey
Township No 17 N. Range No 6 W. Mer. Mich.

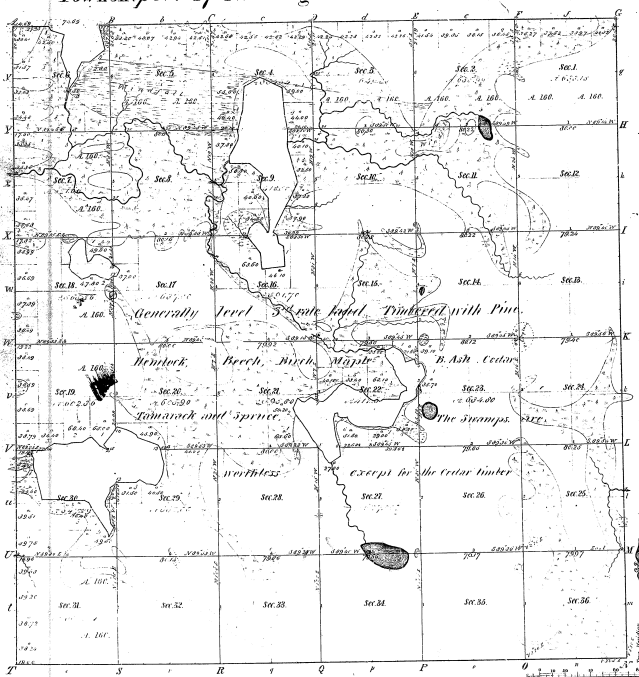

Mileage of					
Path	Courses	Paces	Angles	Paces	Angles

12-14

12-14

Total number of Acres. 217 02.60

Acres Occupied	By Whom Surveyed	Date of Contract	Amount of Interest	When Surveyed	Value of Interest at Date of Survey
		June 12, 1852	\$6,125 00	5 25	\$127
		Apr 18, 1852	\$6,250 00	1 60	\$125
		Apr 26, 1852	\$7,250 00	1 50	\$126

The above copy of Township 17 N. R. 6 W. Mer. Mich. is as actually occupied to the field notes of the survey thereon and in this office, which have been examined and approved.
Surveyor General's Office
Felice, March 28, 1861

Surveyor General's Office
Surveyor