

69


Island in Lake in Sec. 8, T. 18 N. R.

Township N. 4. N. Range N. 6. W. Mer. Mich.

6-27

6-27

Mount this on full sheet

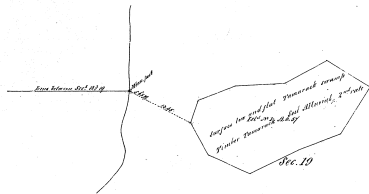

Surveyed by T. H. Wright (under Instructions May 20, 1856) in 1856. Date & Class in no. book. T. 18 N.

The above Map of Township N. 4. North of Range N. 6. West of the Principal Meridian of Michigan is truly conformable to the field notes of the Survey made in file in this Office which have been examined and approved

Surveyor General's Office
Detroit April 20, 1857

Wm. B. Edwards
Sur. Gen.

Exam'd by order of the
Gen'l. Off. March 1876
Register of Deeds